			4	1		
County: Leflore		State Well Report Part 1 – Driller's Log		A	quifer:	
Permit #: GW-458	828	Mississippi Department of Environmental Quality Office of Land and Water Resources P.O. Box 2309			Well #: N 145	
Driller: Irrigatio	n Equipment				L.S. Elevation:	
Date drilling completed:			MS 39225	1	-log #:	
		(601)	961-5210			
		(601) 961	-5228 (fax)			
		hat this report be prepared b				
D	<i>epartment at the a</i> Information on V	bove address within 30 days	·		<i>ll or borehole.</i> hole Location	
(Landox		not for a water well)	· ·	ven or dorei	ioie Location	
•	Corley Moses	,	Latitude: $33 \circ 2$	22'31"	Longitude: 90 ° 18 ' 14	
	1304 Robert E. L	ee Dr.	Method of Lat/Long (cl			
			USGS quad,	🛛 Hand-he	eld GPS, 🔲 Survey-grade GPS	
	Greenwood	Ms 38930	SW 1/ SF 1/	6 Sec 33	Twn Rng	
	City	State Zip code				
		с.	Distance	Direction	Nearest Town	
Telephone No.	() -		<u> </u>	Southwest o	of Phillipstown	
		Wall / D	orehole Data			
		WCH/D	or choic Data			
	1 05/05/0010				Hole diameter: 20"	
Date drilling starte	d: <u>U5/U5/2012</u>	Date drilling completed: 05/	05/2012 Hole de	pth: <u>122</u>		
Location of the sou	urce of any surface w	Date drilling completed: <u>05/</u> ater used for drilling: <u>Surfave</u> ne used in drilling and developm	e Water	pun: <u>122</u>		
Method of dosing a	urce of any surface w and volume of Chlori	ater used for drilling: Surfavo ne used in drilling and developm log run Electric Gamm	e Water nent: 50 PPM			
Location of the sou Method of dosing a Logs run (check al Name of organizat	urce of any surface w and volume of Chlori l applicable): 🛛 No ion running log(s):	ater used for drilling: <u>Surfave</u> ne used in drilling and developn log run Electric Gamm	e Water nent: 50 PPM a Ray 🔲 Density 🗌 So	onic 🗌 Neutr	ron 🗌 Other:	
Location of the sou Method of dosing a Logs run (check al Name of organizat	urce of any surface w and volume of Chlori l applicable): 🛛 No ion running log(s): le (check one): 🔯	ater used for drilling: <u>Surfave</u> ne used in drilling and developn blog run Electric Gamm Water Well Geotechnica	e Water hent: 50 PPM a Ray Density So l/Geological Investigation	onic 🗌 Neutr		
Location of the sou Method of dosing a Logs run (check al Name of organizat	urce of any surface w and volume of Chlori I applicable): 🛛 No ion running log(s): le (check one): 🔯	ater used for drilling: Surfave ne used in drilling and developm log run Electric Gamm Water Well Geotechnica Seismic Survey Other (e Water hent: 50 PPM a Ray Density So l/Geological Investigation describe)	onic 🗌 Neutr n 🔲 Groun	on Other: d Source Heat Pump	
Location of the sou Method of dosing a Logs run (check al Name of organizat Purpose of borehol	urce of any surface w and volume of Chlori I applicable): 🛛 No ion running log(s): le (check one): 🔯 If drilling	ater used for drilling: Surfave ne used in drilling and developm o log run Electric Gamm Water Well Geotechnica Seismic Survey Other (is not related to water well co	e Water hent: 50 PPM a Ray Density So l/Geological Investigation describe) construction, skip the re	onic 🗌 Neutr n 🔲 Groun emainder of t	ron	
Location of the sou Method of dosing a Logs run (check al Name of organizat Purpose of borehol	urce of any surface w and volume of Chlori I applicable): 🛛 No ion running log(s): le (check one): 🔯 If drilling	ater used for drilling: Surfave ne used in drilling and developm log run Electric Gamm Water Well Geotechnica Seismic Survey Other (e Water hent: 50 PPM a Ray Density So l/Geological Investigation describe) construction, skip the re	onic 🗌 Neutr n 🔲 Groun emainder of t	ron	
Location of the sou Method of dosing a Logs run (check al Name of organizat Purpose of borehol Purpose of Well (c	urce of any surface w and volume of Chlori I applicable): X No ion running log(s): le (check one): X If drilling to check one) Hom	ater used for drilling: Surfave ne used in drilling and developm o log run Electric Gamm Water Well Geotechnica Seismic Survey Other (is not related to water well co e Industrial Public Su	e Water hent: 50 PPM a Ray Density So l/Geological Investigation describe) construction, skip the re- pply SI Irrigation	onic 🗌 Neutr n 🗌 Groun emainder of ta Fish Culture	ron	
Location of the sou Method of dosing a Logs run (check al Name of organizat Purpose of borehol Purpose of Well (c	urce of any surface w and volume of Chlori I applicable): X No ion running log(s): le (check one): X If drilling to theck one) Hom l of flow regulation:	ater used for drilling: Surfave ne used in drilling and developm o log run Electric Gamm Water Well Geotechnica Seismic Survey Other (is not related to water well co e Industrial Public Su Valve Other (de	e Water hent: 50 PPM a Ray Density So l/Geological Investigation describe) ponstruction, skip the re pply Irrigation Society escribe)	onic Neutr n Groun emainder of ta Fish Culture	von Other:	
Location of the sou Method of dosing a Logs run (check al Name of organizat Purpose of borehol Purpose of Well (c If flowing, method Static Water Level	urce of any surface w and volume of Chlori I applicable): X No ion running log(s): Ie (check one): X If drilling i theck one) Hom I of flow regulation: : <u>17</u> feet at	ater used for drilling: Surfave ne used in drilling and developm b log run Electric Geotechnica Water Well Geotechnica Seismic Survey Other (destrict) Industrial Public Su Valve Other (destrict) Sove or below (check one) Ia	e Water hent: 50 PPM a Ray Density So l/Geological Investigation describe) ponstruction, skip the re- pply Irrigation Secribe) escribe) and Surface Date m	onic Neutr n Groun emainder of ta Fish Culture	on Other:	
Location of the sou Method of dosing a Logs run (check al Name of organizat Purpose of borehol Purpose of Well (c If flowing, method Static Water Level Method of Measur	urce of any surface w and volume of Chlori I applicable): X No ion running log(s): le (check one): X <i>If drilling i</i> theck one) Hom l of flow regulation: : <u>17</u> feet all rement (check one)	ater used for drilling: Surfave ne used in drilling and developm o log run Electric O log run Electric Water Well Geotechnica Seismic Survey Other (is not related to water well ca e Industrial Public Su Valve Other (depove or below (check one) a steel tape electric tape	e Water hent: <u>50 PPM</u> a Ray Density So a Comparison So describe) pply Solution Solution Solution Solution Solution escribe) and Sourface Date m air line Other:	onic Neutr n Groun emainder of the Fish Culture neasured: 05	on Other:	
Location of the sou Method of dosing a Logs run (check al Name of organizat Purpose of borehol Purpose of Well (c If flowing, method Static Water Level Method of Measur Well depth: <u>122</u>	urce of any surface w and volume of Chlori I applicable): ⊠ No ion running log(s): It (check one): ⊠ <i>If drilling i</i> theck one) ☐ Hom I of flow regulation: : <u>17</u> feet al rement (check one) Well grouted	ater used for drilling: Surfave ne used in drilling and developm o log run Electric Gamm Water Well Geotechnica Seismic Survey Other (is not related to water well ca e Industrial Public Su Valve Other (de pove or below (check one) I a steel tape electric tape to a depth of 10 feet	e Water hent: 50 PPM a Ray Density So l/Geological Investigation describe) pply Irrigation So escribe) and Surface Date m air line other: Type of grout (check o	onic Neutr n Groun emainder of the Fish Culture teasured: 05 one): Neat	on Other:	
Location of the sou Method of dosing a Logs run (check al Name of organizat Purpose of borehol Purpose of Well (c If flowing, method Static Water Level Method of Measur Well depth: <u>122</u> Casing length: <u>4</u>	urce of any surface w and volume of Chlori l applicable): X No ion running log(s): le (check one): X <i>If drilling i</i> theck one) Hom l of flow regulation: : <u>17</u> feet al rement (check one) Well grouted 82 feet	ater used for drilling: Surfave ne used in drilling and developm o log run Electric Gamm Water Well Geotechnica Seismic Survey Other (is not related to water well ca e Industrial Public Su Valve Other (de pove or below (check one) I la steel tape electric tape to a depth of 10 feet Casing diameter: 12	e Water hent: 50 PPM a Ray Density So l/Geological Investigation describe) pply Irrigation Solution escribe) and Surface Date m air line other: Type of grout (check o inches T	onic Neutr n Groun emainder of the Fish Culture heasured: 05 one): Neat	on □ Other:	
Location of the sou Method of dosing a Logs run (check al Name of organizat Purpose of borehol Purpose of Well (c If flowing, method Static Water Level Method of Measur Well depth: <u>122</u> Casing length: <u>4</u> Screen length: <u>4</u>	urce of any surface w and volume of Chlori l applicable): ⊠ No ion running log(s): le (check one): ⊠ <i>If drilling i</i> theck one) □ Hom l of flow regulation: : <u>17</u> feet al rement (check one) Well grouted 82 feet 40 feet	ater used for drilling: Surfave ne used in drilling and developm olog run Electric Gamm Water Well Geotechnica Seismic Survey Other (is not related to water well ca e Industrial Public Su Valve Other (de pove or below (check one) I la steel tape electric tape to a depth of 10 feet Casing diameter: 12 Screen diameter: 12	e Water hent: 50 PPM a Ray Density So l/Geological Investigation describe) pply Irrigation So escribe) and Surface Date m air line other: Type of grout (check o inches T inches T inches T	onic Neutr n Groun emainder of the Fish Culture heasured: 05 one): Neat	on Other:	
Location of the sou Method of dosing a Logs run (check al Name of organizat Purpose of borehol Purpose of Well (c If flowing, method Static Water Level Method of Measur Well depth: <u>122</u> Casing length: <u>4</u> Screen length: <u>4</u>	urce of any surface w and volume of Chlori l applicable): ⊠ No ion running log(s): le (check one): ⊠ <i>If drilling i</i> theck one) □ Hom l of flow regulation: : <u>17</u> feet al rement (check one) Well grouted 82 feet 40 feet	ater used for drilling: Surfave ne used in drilling and developm o log run Electric Gamm Water Well Geotechnica Seismic Survey Other (is not related to water well ca e Industrial Public Su Valve Other (de pove or below (check one) I la steel tape electric tape to a depth of 10 feet Casing diameter: 12	e Water hent: 50 PPM a Ray Density So l/Geological Investigation describe) pply Irrigation So escribe) and Surface Date m air line other: Type of grout (check o inches T inches T inches T	onic Neutr n Groun emainder of the Fish Culture heasured: 05 one): Neat	on □ Other:	
Location of the sou Method of dosing a Logs run (check al Name of organizat Purpose of borehol Purpose of Well (c If flowing, method Static Water Level Method of Measur Well depth: <u>122</u> Casing length: <u>4</u> Screen length: <u>4</u>	urce of any surface w and volume of Chlori l applicable): X No ion running log(s): le (check one): X <i>If drilling i</i> theck one) Hom l of flow regulation: : <u>17</u> feet al rement (check one) Well grouted 82 feet 40 feet .050	ater used for drilling: Surfave ne used in drilling and developm olog run Electric Gamm Water Well Geotechnica Seismic Survey Other (is not related to water well ca e Industrial Public Su Valve Other (de pove or below (check one) I a steel tape electric tape to a depth of 10 feet Casing diameter: 12 Screen diameter: 12 inches Setting depth: From	e Water hent: 50 PPM a Ray Density So l/Geological Investigation describe) pply Irrigation Skip the re- pply Irrigation Intersection Skip the re- scribe) Irrigation Intersection Skip the re- scribe) Irrigation Intersection Skip the re- scribe Intersection Skip the re- scribe Intersection Skip the re- scribe Intersection Skip the re- scribe Intersection Skip the re- Intersection Skip the re- Intersect	onic Neutr n Groun emainder of the Fish Culture heasured: 05 one): Neat Type of casing: Type of screen: t to 120 1	on □ Other:	
Location of the sou Method of dosing a Logs run (check al Name of organizat Purpose of borehol Purpose of Well (c If flowing, method Static Water Level Method of Measur Well depth: <u>122</u> Casing length: <u>4</u> Screen length: <u>4</u>	urce of any surface w and volume of Chlori l applicable): X No ion running log(s): le (check one): X <i>If drilling i</i> theck one) Hom l of flow regulation: : <u>17</u> feet al rement (check one) Well grouted 82 feet 40 feet .050	ater used for drilling: Surfave ne used in drilling and developm olog run Electric Gamm Water Well Geotechnica Seismic Survey Other (is not related to water well ca e Industrial Public Su Valve Other (de pove or below (check one) I la steel tape electric tape to a depth of 10 feet Casing diameter: 12 Screen diameter: 12 inches Setting depth: From le): Gravel packed	e Water hent: 50 PPM a Ray □ Density □ So I/Geological Investigation describe) ponstruction, skip the re pply ⊠ Irrigation □ escribe) and ⊠ surface Date m □ air line □ other: Type of grout (check o inches T inches T inches T inches T inches T inches T inches T inches T	onic Neutr n Groun emainder of the Fish Culture easured: 04 one): Neat Type of casing: Type of screen: t to 120 1 coped C	on □ Other:	
Location of the sou Method of dosing a Logs run (check al Name of organizat Purpose of borehol Purpose of borehol Purpose of Well (c If flowing, method Static Water Level Method of Measur Well depth: <u>122</u> Casing length: <u>4</u> Screen length: <u>4</u> Screen slot size: Type of completio	urce of any surface w and volume of Chlori I applicable): ⊠ No ion running log(s): le (check one): ⊠ <i>If drilling</i> theck one) □ Hom I of flow regulation: : <u>17</u> feet al rement (check one) Well grouted 82 feet 40 feet .050 n (check all applicab	ater used for drilling: <u>Surfave</u> ne used in drilling and developm olog run Electric Gamm Water Well Geotechnica Seismic Survey Other (<u>is not related to water well co</u> e Industrial Public Su Valve Other (de pove or below (check one) I a steel tape electric tape to a depth of <u>10</u> feet Casing diameter: <u>12</u> Screen diameter: <u>12</u> inches Setting depth: From le): Gravel packed I Other (describe):	e Water hent: <u>50 PPM</u> a Ray ☐ Density ☐ So I/Geological Investigation describe) onstruction, skip the re- pply ⊠ Irrigation ☐ escribe) pud ⊠ surface Date m ☐ air line ☐ other: Type of grout (check o inches T inches T inches T inches T inches T inches T	onic Neutr n Groun emainder of ti Fish Culture heasured: 05 one): Neat Type of casing: Type of screen: at to 120 1 coped C	on □ Other:	
Location of the sou Method of dosing a Logs run (check al Name of organizat Purpose of borehol Purpose of Well (c If flowing, method Static Water Level Method of Measur Well depth: <u>122</u> Casing length: <u>4</u> Screen length: <u>4</u> Screen slot size: Type of completio	urce of any surface w and volume of Chlori I applicable): ⊠ No ion running log(s): le (check one): ⊠ <i>If drilling</i> theck one) □ Hom I of flow regulation: : <u>17</u> feet al rement (check one) Well grouted 82 feet 40 feet .050 n (check all applicab	ater used for drilling: Surfave ne used in drilling and developm olog run Electric Gamm Water Well Geotechnica Seismic Survey Other (is not related to water well ca e Industrial Public Su Valve Other (de pove or below (check one) I la steel tape electric tape to a depth of 10 feet Casing diameter: 12 Screen diameter: 12 inches Setting depth: From le): Gravel packed	e Water hent: <u>50 PPM</u> a Ray ☐ Density ☐ So I/Geological Investigation describe) onstruction, skip the re- pply ⊠ Irrigation ☐ escribe) pud ⊠ surface Date m ☐ air line ☐ other: Type of grout (check o inches T inches T inches T inches T inches T inches T	onic Neutr n Groun emainder of ti Fish Culture heasured: 05 one): Neat Type of casing: Type of screen: at to 120 1 coped C	on □ Other:	

MAY 1 5 2012

BY: OLWR

¢

4

The sketch below only required for water wells

If well telescopes, show depths on sketch. Ground level

Å.

.

Description of formations encountered must be provided for all wells and boreholes, unless specifically exempted by regulations

Description of Formations Encountered	From (depth)	
Clay	Ground level	21
Fine Sand	22	38
Fine Sand & Gravel	39	49
Medium Sand & Gravel	50	119
Fine Sand	120	122
Blanked 2' on bottom		

If more than one screen, show location of each on sketch

aid in			n; 2) any permanent structures o er items that may aid in locating	
Landowner Name:	Corley Moses			
I certify that the well/bo Mississippi Department laws. Patrick Chism Print Name of Responsible Lice	of Environmental Quality	ucted, and completed in acco y and the Mississippi Depart 05/10/2012 	ordance with all applicable requir ment of Health regulations, if app Grant Signature of Licensee	Form: OLWR-SWR-1A (04/08) rements of the plicable, and state <u>RECEIVED</u>
	n-A-Disk · 214-340-9429 · Form		organizate of Literate	MAY 1 5 2012 BY: OLWR

STATE WELL REPORT

County:	Leflore	
Permit #:	GW-45828	
Driller:	Irrigation Equ	ipment
Date drilli	ing completed: 05/0	5/2012
	formation from bloc	

Part 2 **Pump Installer's Completion Report**

Mississippi Department of Environmental Quality Office of Land and Water Resources P.O. Box 2309 Jackson, MS 39225 (601) 961-5210 (601) 961-5228 (fax)

For Office Use Only:			
Aquifer:			
Well #:	N145		
Elevation:	••••••••••••••••••••••••••••••••••••••		


٦

)

This part of the report must be completed by a licensed water well contractor or a licensed pump installer. A copy of Part 1 of the report must be attached and both parts filed with the Department at the above address within 30 days of well completion.

Well Owner Information Owner Name: Corley Moses			Well Location Latitude: 33 22' 31 N Longitude: 90 18' 14 W		
			🔲 USGS quad, 🛛 Hand-held GPS, 📋 Survey-grade GPS		
_	Greenwood	Ms 38930	<u>SW 1/4 SE 1/4 Sec 33 T 18N R 1W</u>		
	City	State Zip code	Distance Direction Nearest Town		
Telephone No() -		<u>1</u> Miles <u>Southwest</u> of <u>Phillipstown</u>		
	Pump Type Check one		Power Type Check one		
🗌 Air Lift	🔲 Jet	Submersible	Diesel Engine 🔲 Gasoline Engine 🗌 Natural Gas		
Bucket	Piston	🛛 Turbine	Electric Motor Hand Tractor PTO		
Centrifugal	Rotary	Flowing Well	Windmill Other (specify):		
Other (specify):		· · · · · · · · · · · · · · · · · · ·	Horse Power Rating of Motor: 40		
Date Pump Installe	d: 05/08/2012	····	Setting Depth: 70 feet		
Rated Pump Capac	ity <u>1600+/-</u>	Gallons Per Minute	Number of Stages: 2		
	Pump Test Dat	a	Method of Measuring Water Level Check one		
Date Well Tested:			Air Line Electric Measuring Line Steel Tape		
		Feet Below Land Surface	Other (specify):		
Pumping Water Le	vel (B):	Feet Below Land Surface			
Drawdown [(B) -	(A)]:	Feet Below Land Surface	For flowing well, measured shut in head: feet		
Test Pumping Rate	:	Gallons Per Minute	Well yielded GPM with a drawdown of		
	Test (minimum 4 hours):		feet after hours of pumping		
This is for (c	heck one): New	w Well Replaces	ment of Existing Pump Repair of Existing Pump		
I HEREBY CERT	IFY that the above statem	ents are true to the best of n	ny knowledge. RECEIVE		
Patrick Chism	n ump Installer and License	0695 No. (if applicable)	Signature of Pump Installer		
FILLE HALHE ULF			MAY 1 5 2019 Form: OLWR'SWR-16 (197-09)		
Form provided by Fr	orms On-A-Disk · 214-340-94	29 · FormsOnADisk.com	BY: OLW		
			and a set of the set o		

N145

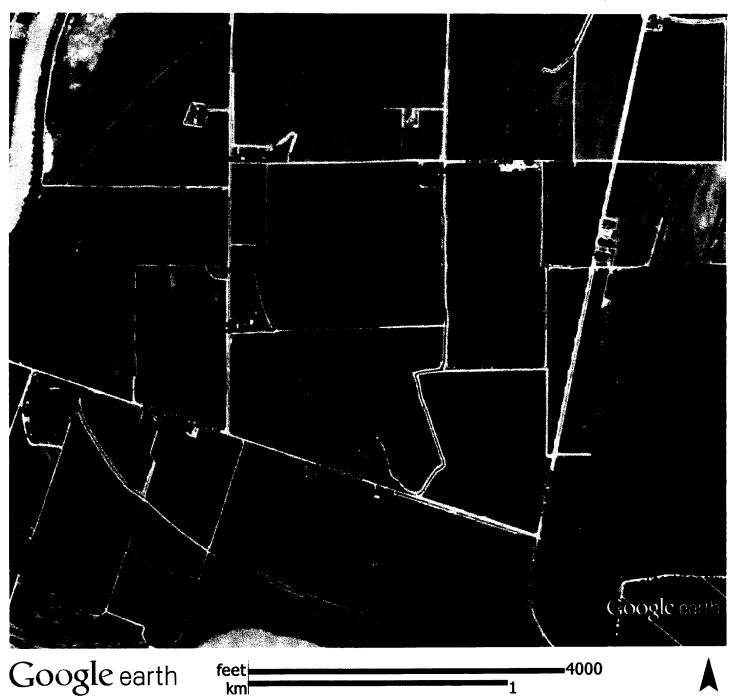



MAY 1 5 2012

BY: OLWR