

LEFLORE
N 2001
6-8-77

MISSISSIPPI
 BOARD OF WATER COMMISSIONERS
 416 North State Street
 Jackson, Mississippi 39201

15J

WATER WELL DRILLERS LOG

BUTANE GAS CO. OF GREENWOOD

LeFlore

6-8-77 19 date well completed firm name county well located


LANDOWNER:	description of formations encountered	from	to
W.P. Kimbrough			
Itta Bendt (mailing address)	SAND & CLAY	30	70
	SAND & GRAVEL	70	84
WELL LOCATION:			
sec. <u>9</u> T. <u>18</u> N. R. <u>1</u> E. S. <u>W</u>			
<u>0</u> miles (distance) of <u>Quit</u> (direction) of <u>Quit</u> (nearest town)			
WELL PURPOSE: <u>Home</u> (home, irrigation, municipal, industrial)			
WELL COMPLETION DATA:			
(1) diameter (inches) <u>4"</u>			
(2) total depth (feet) <u>74'</u>			
(3) static water level (feet) <u>18'</u> below above top of ground.			
(4) casing <u>PVC</u> <u>74'</u> (material) (depth) <u>4"</u> if telescope see back. (size)			
(5) screen <u>20'</u> <u>74'</u> (length) (depth to top) <u>4"</u> <u>PVC</u> (size) (material)			
(6) pump <u>1/2</u> <u>10</u> (HP) (yield gpm) <u>Elec</u> (type power)			
(7) electric log <u>NO</u> (yes or no)			
(organization running log)			
(8) how well bottom plugged <u>Back Pressure Valve</u>			
DRILLERS REMARKS:			

RECEIVED
 JUN 20 1977

MISS. BD. OF WATER COMMISSIONERS

If well telescopes please sketch and show depths.

GROUND LEVEL

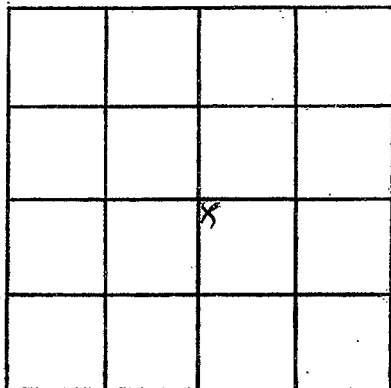

SECTION 9

Please indicate well location X.

ADDITIONAL INFORMATION

If more than one screen, show locations of each on sketch.