

MISSISSIPPI DEPARTMENT OF NATURAL RESOURCES

Bureau of Land and Water Resources

Southport Mall

P.O. Box 10631

Jackson, Mississippi 39209

WATER WELL DRILLERS LOG

LEFLORE
N 2004
12/2/81

BUTANE GAS CO. OF GREENWOOD *Leflore*

POST OFFICE BOX 1135

GREENWOOD, MISS. 38930

12-2  
date well completed

19 81

firm name county well located

LANDOWNER:  
*Walter Hodges*  
*801 Cheatum Belzoni*  
(mailing address) *39038*

description of formations encountered	from	to
<i>Clay</i>	<i>0</i>	<i>20</i>
<i>Sand</i>	<i>20</i>	<i>60</i>
<i>Sand + fine gravel</i>	<i>60</i>	<i>103</i>

WELL LOCATION:  
sec. *34* T. *18* N. R. *1* E. W. *4*  
*4* miles *E* of *Morgan*  
(distance) (direction) (nearest town)

WELL PURPOSE:  
(home, irrigation, municipal, industrial)

- WELL COMPLETION DATA:
- (1) diameter (inches) 4"
  - (2) total depth (feet) 103
  - (3) static water level (feet) 30 <sup>below</sup> ~~above~~ top of ground.
  - (4) casing PVC, 83'  
(material) (depth)  
4"  
(size) if telescope see back.
  - (5) screen 20', 83'  
(length) (depth to top)  
4", PVC  
(size) (material)
  - (6) pump 1, 20  
(HP) (yield gpm)  
Electric  
(type power)
  - (7) electric log NO  
(yes or no)  
NO  
(organization running log)
  - (8) how well bottom plugged Backwash Valve

DRILLERS REMARKS:  
*Richard*

DEPT. OF NATURAL RESOURCES  
BUREAU OF LAND & WATER RESOURCES

DEC 29 1981


RECEIVED

If well telescopes please sketch and show depths.

GROUND LEVEL

81 DEC 30 A 8: 31

RECEIVED

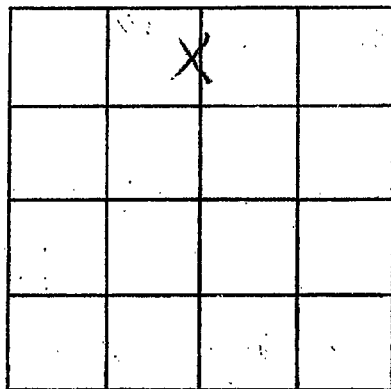

SECTION 34

Please indicate well location X.

ADDITIONAL INFORMATION

If more than one screen, show locations of each on sketch.