

LEFLORE
N 206

MISSISSIPPI DEPARTMENT OF NATURAL RESOURCES
Bureau of Land and Water Resources
Southport Mall
P.O. Box 10631
Jackson, Mississippi 39209
WATER WELL DRILLERS LOG

5-12- 1987 BUTANE GAS CO. OF GREENWOOD LeFlore
date well completed firm name county well located

LANDOWNER:
Muse Flynn Service
MORGAN City
(mailing address)

description of formations encountered	from	to
<u>CLAY</u>	<u>0</u>	<u>10</u>
<u>SAND</u>	<u>10</u>	<u>78</u>
<u>GRAVEL</u>	<u>78</u>	<u>100</u>

WELL LOCATION:
sec. 31 T. 18 N R. 1
1/2 miles E of MORGAN CITY
(distance) (direction) (nearest town)

WELL PURPOSE:
(home, irrigation, municipal, industrial)

WELL COMPLETION DATA:

(1) diameter (inches) 4"

(2) total depth (feet) 100

(3) static water level (feet) 25 below above top of ground.

(4) casing PVC, 80
(material) (depth)
4"
(size) if telescope see back.

(5) screen 20, 80
(length) (depth to top)
4", PVC
(size) (material)

(6) pump 1 1/2
(HP) (yield gpm)
Elec.
(type power)

(7) electric log NO
(yes or no)
(organization running log)

(8) how well bottom plugged
Back Pressure Valve

DRILLERS REMARKS:


RECEIVED

JUN 03 1987

Department of Natural Resources
Bureau of Land & Water Resources

If well telescopes please sketch and show depths.

GROUND LEVEL

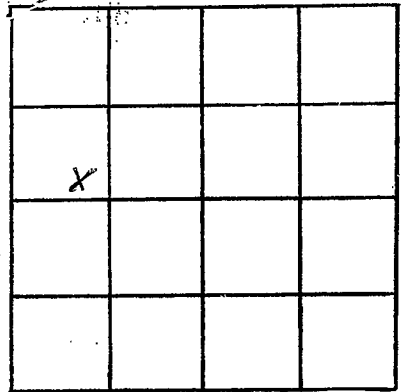

SECTION 31

Please indicate well location X.

ADDITIONAL INFORMATION

If more than one screen, show locations of each on sketch.