

CODED

10

11-15-60

WATER WELL DRILLERS LOG

Date: 11/15, 1960, Driller: Delta-Western Exp. Co. Inc County LeFlore
 (Name)

(1) Owner of Land: Town of
 (Name)
Sidon Mississippi
 (Address)

(2) Location: NW 1/4, SW 1/4, Sec. 21 T. 10 N. R. 10 E
 (distance) (direction) (Nearest Town)

(3) Topography: X
 (Hilly) (Flat) (Level)

(4) Purpose of Well: Municipal
 (Domestic Irrigation
 Municipal, Industrial, Other)

Description & Color of Materials Sand, Clay, Red Clay, Shell, etc.	Thick- ness Feet	Depth Feet
Clay	15	15
Sand	85	100
Gravel and Sand	48	148
Clay	32	180
Sand	65	245
Light	5	250
Clay	45	295
Clay	15	310
Sand	15	325
Shale	15	340
Sand	15	355
Shale	10	365
Sand	5	370
Sand stringers in shale	40	410
Sand	10	420
Shale	5	425
Sand	20	445
Soft Clay	35	480
Clay with sand stringers	71	551
Sandy Clay	19	570
Rock	5	575
Sand and Clay	23	598
Shale	32	630
Rock	10	640
Sand	20	660
Clay	15	675
Sand with clay stringers	25	700
Sand with clay shale "	100	800
Wine Sand	20	820
Fine Sand with shale thin	60	880
Fine sand	40	920
Good water sand	80	1000
Shale with sand stringers	44	1044

Information upon completion of well:

(1) Diameter 3 inches.

(2) Total Depth 1035 feet.

(3) Water Level +20 feet below top of ground.

(4) Cased to 990', Size 3"


(5) Screen: Size 2", Length 30'

(6) Were any formations sealed against pollution?
 _____ yes, _____ no.

If YES depth of formation _____

Why _____

Drillers Remarks: _____

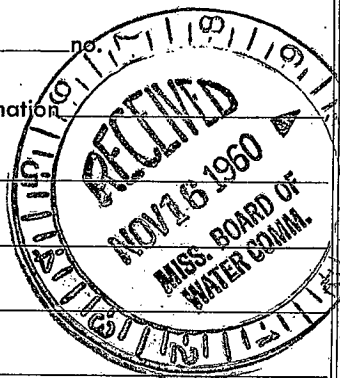

(Use Back Side)

Well No.

