

Leflore
Ø 17
6-9-70

MISSISSIPPI
 BOARD OF WATER COMMISSIONERS
 416 North State Street
 Jackson, Mississippi 39201

WATER WELL DRILLERS LOG

CODED

June 9 19 70 Boring Co. Leflore
 date well completed firm name county well located

LANDOWNER: J. D. Woodpe
SIDON, MISS.

description of formations encountered	from	to
CLAY	0	18
CLAY SAND GRAVEL	18	130
CLAY	130	170
SAND	170	215
CLAY	215	290
SHELL CLAY	290	320
SAND SHELL CLAY	320	950
WHITE SAND	950	1007

(mailing address)

WELL LOCATION:
 sec. 20 T 18 R 1 E
0 miles 7 of SIDON
 (distance) (direction) (nearest town)

WELL PURPOSE: HOME
 (home, irrigation, municipal, industrial)

WELL COMPLETION DATA:

- (1) diameter (inches) 4 x 2
- (2) total depth (feet) 1007
- (3) static water level (feet) 20" below above top of ground.
- (4) casing 4" STEEL 105'
2" (material) (depth)
8 7/8" STEEL
 (size) if telescope see back.
- (5) screen 30' 2" 1007'
 (length) (depth to top)
2" STAINLESS STEEL
 (size) (material)
- (6) pump _____ (HP) _____ (yield gpm)
 _____ (type power)
- (7) electric log _____ (yes or no)
 _____ (organization running log)
- (8) how well bottom plugged: BACK WASH VALVE

CODED

JUL 11 1970

DRILLERS REMARKS:

MISS. BRT. OF WATER


If well telescopes please sketch and show depths.

GROUND LEVEL

105

872

30

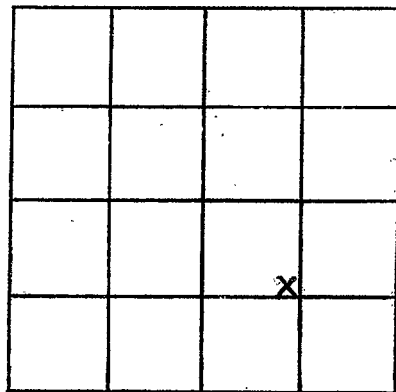

SECTION 30

Please indicate well location X.

ADDITIONAL INFORMATION

If more than one screen, show locations of each on sketch.