

LEFLORE MISSISSIPPI BOARD OF WATER COMMISSIONERS

019
12-30-65

WATER WELL DRILLERS LOG CODED

Date: DEC 30, 1965, Driller: DELTA DRILLING Co. County LEFLORE
(Name)

(1) Owner of Land: CHARLIE MYERS (Name)	Description & Color of Materials Sand, Clay, Red Clay, Shell, etc.	Thick- ness Feet	Depth Feet
SIDON, MISS (Address)	gumbo	22	22
NW 1/4, NE 1/4, Sec. 4 TOWN 10E	Sand	51	73
_____ miles _____ of _____ (distance) (direction) (Nearest Town)	gravel	43	116
(3) Topography: _____ (Hilly) (Flat) (Level)	gumbo	145	261
(4) Purpose of Well: DOMESTIC (Domestic Irrigation Municipal, Industrial, Other)	Shale	14	275
_____	Sand	50	325
_____	gumbo	13	338
_____	Sand	20	358
_____	Shale	113	471
_____	Sand w/ROCKS -	64	535
_____	Sand	30	565


Information upon completion of well:

- (1) Diameter _____ inches.
- (2) Total Depth 565 feet.
- (3) Water Level FLOWS feet below top of ground. 3"
- (4) Cased to 545, Size 2"
- (5) Screen: Size 2", Length 20'
- (6) Were any formations sealed against pollution?
_____ yes, _____ no.

If YES depth of formation _____

Why _____

Drillers Remarks: _____

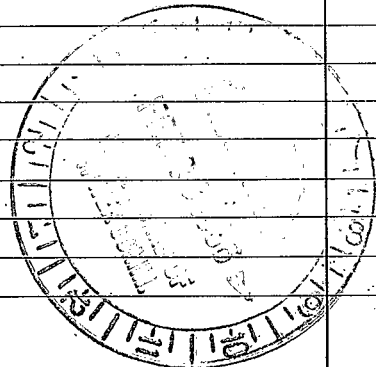

(Use Back Side)

Well No.

