

Leflore
 D 22
 7/18/75

MISSISSIPPI
 BOARD OF WATER COMMISSIONERS
 416 North State Street
 Jackson, Mississippi 39201

CODED

WATER WELL DRILLERS LOG

7-18-75 19 BUTANE GAS CO. OF GREENWOOD Leflore
 date well completed firm name county well located

LANDOWNER:	description of formations encountered	from	to
Jesse Stockton	Clay	0	10
Sidon	SAND	10	60
(mailing address)	SAND + GRAVEL	60	120
WELL LOCATION:	Clay	120	240
sec. 30 T 18 N R 1 E 15J	SAND + Siltale	240	420
1 1/2 miles SW of Sidon	Clay	420	490
(distance) (direction) (nearest town)	Siltale	490	570
WELL PURPOSE: Home	SAND	570	600
(home, irrigation, municipal, industrial)	Siltale	600	690
WELL COMPLETION DATA:	SAND + Siltale	690	810
(1) diameter (inches) 4 X 2	Clay	810	850
(2) total depth (feet) 1027	SAND	850	890
(3) static water level (feet) 15 below top of ground.	FINE SAND	890	985
(4) casing Steel 997 (material) (depth)	COARSE SAND	985	1027
4 X 2 (size) If telescope see back.			
(5) screen 30 997 (length) (depth to top)			
2" Stainless (size) (material)			
(6) pump 2 40 (HP) (yield gpm)			
Elec. (type power)			
(7) electric log No (yes or no)			
(organization running log)			
(8) how well bottom plugged Back Pressure Valve			
DRILLERS REMARKS:			

CODED

WATER COMMISSIONERS
 JUL 21 1975

WATER COMMISSIONERS


If well telescopes please sketch and show depths.

GROUND LEVEL

105' - 4" CASING →

892' - 2" CASING →

30' - 2" SCREEN →

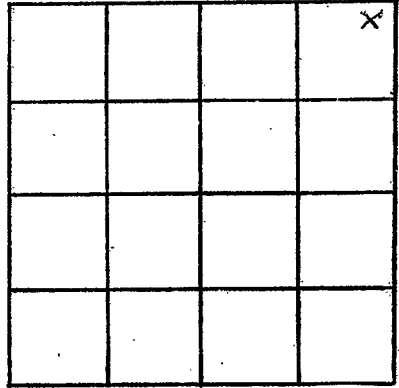

SECTION 30

Please indicate well location X.

ADDITIONAL INFORMATION

If more than one screen,
show locations of each on sketch.