

Leflore  
024  
11-66

# MISSISSIPPI BOARD OF WATER COMMISSIONERS

## WATER WELL DRILLERS LOG CODED

Date: 11-8, 1966, Driller: Butane Gas Co. County: Leflore  
(Name)


(1) Owner of Land: B. H. Mc Geary  
(Name)  
Sidon, Miss.  
(Address)

(2) Location: W 1/4, NW 1/4, Sec. 16 T 18 R 1 E,  
1 1/2 miles: N, of Sidon  
(distance) (direction) (Nearest Town)

(3) Topography: \_\_\_\_\_  
(Hilly) (Flat) (Level)

(4) Purpose of Well: Domestic  
(Domestic Irrigation  
Municipal, Industrial, Other)

Description & Color of Materials Sand, Clay, Red Clay, Shell, etc.	Thick- ness Feet	Depth Feet
Clay	30	30
Fine Sand	30	60
Sand + Gravel	40	100

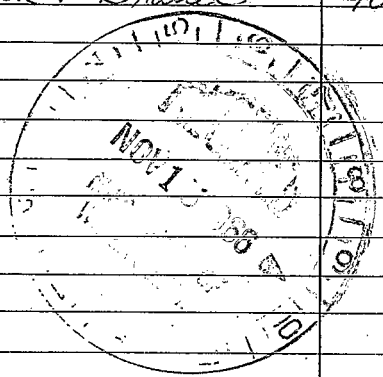

### Information upon completion of well:

(1) Diameter 4 3/4 inches.  
 (2) Total Depth 100 feet.  
 (3) Water Level 18' feet below top of ground.  
 (4) Cased to 90, Size 2  
 (5) Screen: Size 2", Length 10'  
 (6) Were any formations sealed against pollution?  
 \_\_\_\_\_ yes,  no.

CODED

If YES depth of formation \_\_\_\_\_  
Why \_\_\_\_\_  
Drillers Remarks: \_\_\_\_\_

(Use Back Side)

Well No.

