

Leclare
 025
 11-67

MISSISSIPPI
 BOARD OF WATER COMMISSIONERS
 416 North State Street
 Jackson, Mississippi 39201

CODED

WATER WELL DRILLERS LOG

Nov 24 67, 19 *Butane Gas of Greenwood Leclare*
 date well completed firm name county well located

LANDOWNER:

J.C. Winter

description of formations encountered

from to

Rt 1 - Sidon, Miss
 (mailing address)

<i>Clay</i>	<i>0</i>	<i>15</i>
<i>Coarse Sand & Gravel</i>	<i>15</i>	<i>67</i>
<i>Clay</i>	<i>67</i>	<i>120</i>
<i>Sand & Clay</i>	<i>120</i>	<i>210</i>
<i>Clay</i>	<i>210</i>	<i>280</i>
<i>Shale</i>	<i>280</i>	<i>315</i>
<i>Green Sand</i>	<i>315</i>	<i>330</i>
<i>Shale</i>	<i>330</i>	

WELL LOCATION:

sec *1* T *18* N R *1* E
3 miles *SE* of *Greenwood*
 (distance) (direction) (nearest town)


WELL PURPOSE: *HOME*
 (home, irrigation, municipal, industrial)

342' T.D.

WELL COMPLETION DATA:

- (1) diameter (inches) *2"*
- (2) total depth (feet) *330'*
- (3) static water level (feet) *4'* below top of ground.
- (4) casing *2" Galv.* *320'*
 (material) (depth)
2"
 (size) if telescope see back.
- (5) screen *10'* *320'*
 (length) (depth to top)
3" *STAINLESS STEEL*
 (size) (material)
- (6) pump *3/4* *5*
 (HP) (yield gpm)
Electric
 (type power)
- (7) electric log *No*
 (yes or no)

CODED

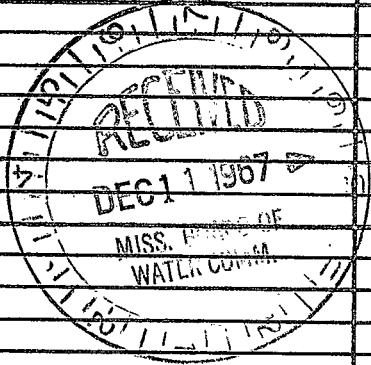

(organization running log)

(8) how well bottom plugged
Back Pressure Valve

DRILLERS REMARKS:

If well telescopes please sketch and show depths.

GROUND LEVEL

			X

SECTION 1

Please indicate well location X.

ADDITIONAL INFORMATION

If more than one screen, show locations of each on sketch.