

LeFlore
 026
 10-2-75

MISSISSIPPI
 BOARD OF WATER COMMISSIONERS
 416 North State Street
 Jackson, Mississippi 39201

CODED

WATER WELL DRILLERS LOG

10-2-75 19 BUTANE GAS CO. OF GREENWOOD LeFlore
 date well completed firm name county well located

LANDOWNER:
 LeFlore Flying Service
 S. Low
 (mailing address)

description of formations encountered	from	to
CLAY	0	10
SAND	10	60
SAND & GRAVEL	60	100

WELL LOCATION:
 sec. 28 T. 18 N. R. 1 E. 155
 1 miles SE of Sidon
 (distance) (direction) (nearest town)

WELL PURPOSE:
 (home, irrigation, municipal, industrial)

- WELL COMPLETION DATA:
- (1) diameter (inches) 4"
 - (2) total depth (feet) 100
 - (3) static water level (feet) 15 below above top of ground.
 - (4) casing PVC 80 (material) (depth)
 If telescope see back.
 (size)
 - (5) screen 20 80 (length) (depth to top)
 4" PVC (size) (material)
 - (6) pump 3/4 19 (HP) (yield gpm)
 Elec. (type power)
 - (7) electric log No (yes or no)
 - (organization running log)
 - (8) how well bottom plugged

CODED


REGISTERED
 OCT - 6 1975

DRILLERS REMARKS:

MISS. RD. OF WA

If well telescopes please sketch and show depths.

GROUND LEVEL

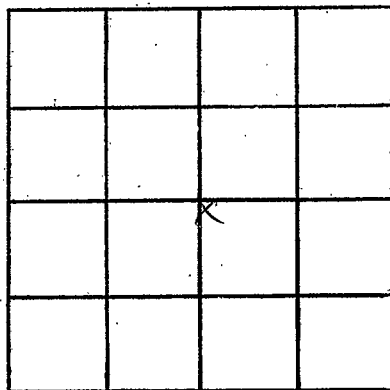

SECTION 28

Please indicate well location X.

ADDITIONAL INFORMATION

If more than one screen, show locations of each on sketch.