

0-34  
9-10-65

WATER WELL DRILLERS LOG

**CODED**

**CODED**

Date: Sept 10, 1965, Driller: Delta Drilling Co County LeFlore  
(Name)

1499

L.E. SIMS +

(1) Owner of Land: HENRY MILICAN

(Name)

Sidon, Miss

(Address)

(2) Location: 1/4, 1/4, Sec. 31 T8R1E,

           miles            of             
(distance) (direction) (Nearest Town)

(3) Topography:            (Hilly) (Flat) (Level)

(4) Purpose of Well: Domestic  
(Domestic Irrigation, Municipal, Industrial, Other)

Information upon completion of well:

(1) Diameter 3 inches.

(2) Total Depth 1018 feet. Total Depth of HOLE - 1084'

(3) Water Level Flows feet below top of ground.

(4) Cased to 998', Size 2 1/2" - 2", 747' - 3"

(5) Screen: Size 2", Length 20'

(6) Were any formations sealed against pollution?  
           yes,            no.


If YES depth of formation           

Why           

Drillers Remarks: 21' Lap of 2" in 3" pipe-

Description & Color of Materials Sand, Clay, Red Clay, Shell, etc.	Thick-ness Feet	Depth Feet
Sand	57	52
Gravel	62	114
Sand	19	133
Gumbo	95	228
Shale	22	250
Sand	95	345
Gumbo	27	372
Shale	48	420
Gumbo	32	452
Shale	20	472
Gumbo w/rocks-	72	544
Shale	62	606
Sand w/rocks-	78	684
Shale w/rocks-	63	747
Gumbo	8	755
Sand w/rocks-	65	820
Shale	22	842
Sand	52	894
Gumbo	12	906
Shale	21	927
Sand	32	959
Gumbo	10	969
Sand	67	1036
Gumbo	15	1051
Shale	33	1084

**CODED**

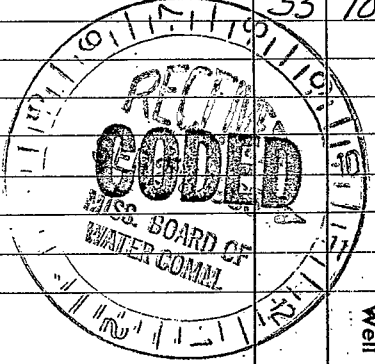

(Use Back Side)

Well No.

100

100