

LEFLORE  
 36  
 3/6/78

MISSISSIPPI  
 BOARD OF WATER COMMISSIONERS  
 416 North State Street  
 Jackson, Mississippi 39201  
 WATER WELL DRILLERS LOG

CODED

March 6 1978 Bruce Berryman - Leflore  
 date well completed firm name county well located

LANDOWNER: Refuge Plantation  
 Rt. 1. Box 36  
 Greenwood. MS 38930

description of formations  
 encountered

from to

Clay	0	20
Sand	20	60
Sand & Gravel	60	120
Clay	120	180
Sand	180	260
Clay	260	280
Sand	280	320
Shale	320	340
Sand	340	380
Clay	380	400
Shale	400	500
Shale & Rock	500	520
Shale	520	530
Sand	530	560
Shale	560	580

(mailing address)

WELL LOCATION:

sec. 32 T 18 N R 1 E  
 3 miles S of SIDON  
 (distance) (direction) (nearest town)

WELL PURPOSE: Home  
 (home, irrigation, municipal, industrial)

WELL COMPLETION DATA:

- (1) diameter (inches) 4" x 2"
- (2) total depth (feet) 560 ft.
- (3) static water level (feet) flow above top of ground 4' blk. - 126' 2" galv. - 414'
- (4) casing (material) (depth)

(size) if telescope see back.

- (5) screen 20' 540'  
 (length) (depth to top)  
 .010 Stainless steel  
 (size) (material)

- (6) pump 1 1/2 35  
 (HP) (yield gpm)

Electric  
 (type power)

- (7) electric log NO  
 (yes or no)

(organization running log)

- (8) how well bottom plugged B.P.V.


DRILLERS REMARKS:

RECEIVED  
 NOV - 7 1978

MISS. BD. OF WATER COMMISSIONERS

If well telescopes please sketch and show depths.

GROUND LEVEL

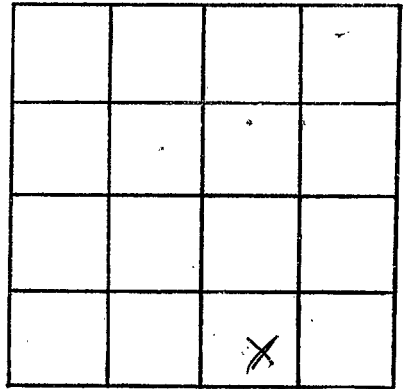

SECTION 32

Please indicate well location X.

ADDITIONAL INFORMATION

If more than one screen,  
show locations of each on sketch.