

MISSISSIPPI DEPARTMENT OF NATURAL RESOURCES

Bureau of Land and Water Resources

Southport Mall

P.O. Box 10631

Jackson, Mississippi 39209

WATER WELL DRILLERS LOG

CODED

Leflore
 ① 44

6-9-1982
 date well completed

Dyer Well
 firm name

Leflore
 county well located

LANDOWNER: *Jul Thomas*

description of formations encountered

from

to

(mailing address)

WELL LOCATION:

sec 27 T-18 N R-1 E
 S W
3 miles NE of Auger
 (distance) (direction) (nearest town)

<i>Clay</i>	<i>0</i>	<i>28</i>
<i>fine sand</i>	<i>28</i>	<i>38</i>
<i>sand</i>	<i>38</i>	<i>68</i>
<i>sand & gravel</i>	<i>68</i>	<i>106</i>

WELL PURPOSE:

(home, irrigation, municipal, industrial)

WELL COMPLETION DATA:

- (1) diameter (inches) 16
- (2) total depth (feet) 106
- (3) static water level (feet) 18 below above top of ground.
- (4) casing Steel, 80
 (material) (depth)
16 if telescope see back.
 (size)
- (5) screen 40, 66
 (length) (depth to top)
16, Mild Steel
 (size) (material)
- (6) pump 60, 2000
 (HP) (yield gpm)
diesel
 (type power)
- (7) electric log no
 (yes or no)

(organization running log)

(8) how well bottom plugged plate


DRILLERS REMARKS:

DEPT. OF NATURAL RESOURCES
 BUREAU OF LAND & WATER RESOURCES

SEP 30 1982
 RECEIVED

If well telescopes please sketch and show depths.

GROUND LEVEL

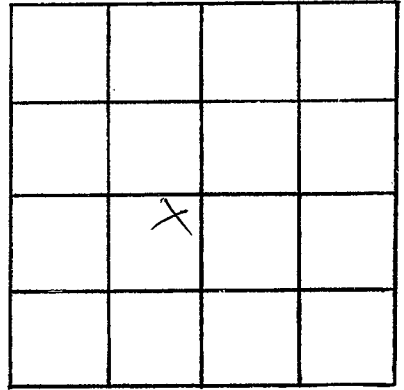

SECTION 27

Please indicate well location X.

ADDITIONAL INFORMATION

If more than one screen,
show locations of each on sketch.