

MISSISSIPPI DEPARTMENT OF NATURAL RESOURCES

Bureau of Land and Water Resources

Southport Mall

P.O. Box 10631

Jackson, Mississippi 39209

WATER WELL DRILLERS LOG

CODED

*Leflore*  
 Q 45

6-9-82 *Dyer Well* *Leflore*  
 date well completed firm name county well located

LANDOWNER: *Gal Thomas*  
 (mailing address)

description of formations encountered	from	to
<i>C. Lay</i>	<i>0</i>	<i>12</i>
<i>Fine Sand</i>	<i>12</i>	<i>28</i>
<i>Sand</i>	<i>28</i>	<i>41</i>
<i>Sand &amp; Gravel</i>	<i>41</i>	<i>103</i>

WELL LOCATION:  
 sec. *21* T. *18* N. R. *1* E.  
*3* miles *NW* of *Crisler*  
 (distance) (direction) (nearest town)

WELL PURPOSE:  
 (home, irrigation, municipal, industrial)

- WELL COMPLETION DATA:
- (1) diameter (inches) *16*
  - (2) total depth (feet) *113*
  - (3) static water level (feet) *14* below top of ground.
  - (4) casing *Steel*, *90* (material), (depth)  
*16* (size) if telescope see back.
  - (5) screen *40* (length), *73* (depth to top)  
*16* (size), *mild Plastic* (material)
  - (6) pump *60* (HP), *2000* (yield gpm)  
*electric* (type power)
  - (7) electric log *No* (yes or no)
  - (organization running log)
  - (8) how well bottom plugged *Plate*


DRILLERS REMARKS:

DEPT. OF NATURAL RESOURCES  
 BUREAU OF LAND & WATER RESOURCES

SEP 30 1982  
 RECEIVED

If well telescopes please sketch and show depths.

GROUND LEVEL

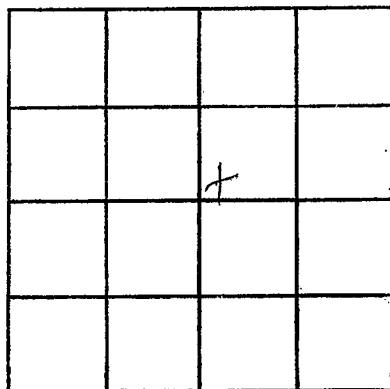

SECTION 21

Please indicate well location X.

ADDITIONAL INFORMATION

If more than one screen, show locations of each on sketch.