

MISSISSIPPI DEPARTMENT OF NATURAL RESOURCES

Bureau of Land and Water Resources

Southport Mall

P.O. Box 10631

Jackson, Mississippi 39209

WATER WELL DRILLERS LOG

CODED

LEFLORE
 046
 5-24-84

5/25/84 19 Doyen Well Leflore
 date well completed firm name county well located

LANDOWNER:
J. Ted Thomas
Cruger, Miss.
 (mailing address)

description of formations encountered	from	to
<u>Clear</u>	<u>0</u>	<u>28</u>
<u>Hard Sand</u>	<u>28</u>	<u>60</u>
<u>Sand & gravel</u>	<u>60</u>	<u>100</u>

WELL LOCATION:
 sec 31 T 18 N R 1 E
4 miles SW of Sidon
 (distance) (direction) (nearest town)

WELL PURPOSE: drill
 (home, irrigation, municipal, industrial)

- WELL COMPLETION DATA:
- (1) diameter (inches) 16
 - (2) total depth (feet) 100'
 - (3) static water level (feet) 24' below above top of ground.
 - (4) casing STEEL, 60,
 (material) (depth)
16 If telescope see back.
 (size)
 - (5) screen 40, 60
 (length) (depth to top)
16, STEEL
 (size) (material)
 - (6) pump 40 1200
 (HP) (yield gpm)
DIES
 (type power)
 - (7) electric log No
 (yes or no)
No
 (organization running log)
 - (8) how well bottom plugged STEEL PIPE

DRILLERS REMARKS:


DEPT. OF NATURAL RESOURCES
 BUREAU OF LAND & WATER RESOURCES

JUL - 2 1984

RECEIVED

If well telescopes please sketch and show depths.

GROUND LEVEL

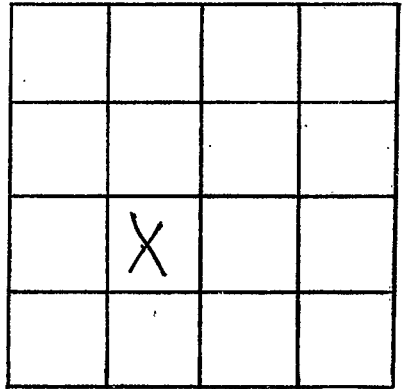

SECTION 31

Please indicate well location X.

ADDITIONAL INFORMATION

If more than one screen, show locations of each on sketch.