

MISSISSIPPI DEPARTMENT OF NATURAL RESOURCES

Bureau of Land and Water Resources

Southport Mall

P.O. Box 10631

Jackson, Mississippi 39209

WATER WELL DRILLERS LOG

CODED

LEFLORE
 47

4-28
 date well completed

1986 BUTANE GAS CO. OF GREENWOOD
 firm name

LeFlore
 county well located

LANDOWNER:	description of formations encountered	from	to
McNair + Porter Farms Sidon Miss. (mailing address)			
WELL LOCATION: sec. 17 T 18 N R 1 E 1 miles NW of Sidon (distance) (direction) (nearest town)	WELL PURPOSE: (home, irrigation, municipal, industrial)	WELL COMPLETION DATA:	
(1) diameter (inches) 4" x 2"	(2) total depth (feet) 126'-4" / 856'	(3) static water level (feet) _____ below above top of ground.	(4) casing Steel 4" 126' 2" 856' (material) (depth)
(5) screen 20' 902' (length) (depth to top) 2" Steel (size) (material)	(6) pump _____ (HP) _____ (yield gpm) Elect (type power)	(7) electric log No (yes or no) No (organization running log)	(8) how well bottom plugged Barkish Valve
DRILLERS REMARKS: Richard Vest			

CODED

RECEIVED
 MAY 28 1986
 Department of Natural Resources
 Bureau of Land & Water Resources


If well telescopes please sketch and show depths.

GROUND LEVEL

126' - 4" casing →

856' - 2" casing

20' - 2" screen →

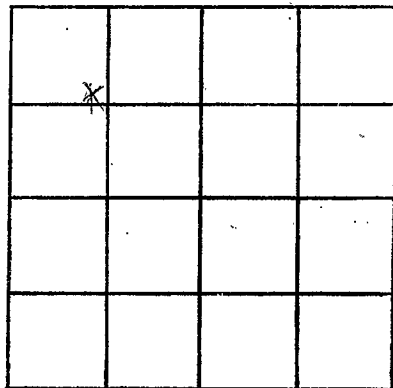

SECTION 17

Please indicate well location X.

ADDITIONAL INFORMATION

If more than one screen, show locations of each on sketch.