

MISSISSIPPI DEPARTMENT OF NATURAL RESOURCES

Bureau of Land and Water Resources

Southport Mall

P.O. Box 10631

Jackson, Mississippi 39209

WATER WELL DRILLERS LOG

CODED

LEFLORE  
 Φ 48

BUTANE GAS COMPANY  
 OF GREENWOOD

5-4-86  
 date well completed

Leflore  
 county well located


LANDOWNER:	description of formations encountered	from	to
Scott Wooten	Clay	0	12
Sidon	FINE SAND	12	50
(mailing address)	SAND & PEA GRAVEL	50	75
WELL LOCATION:	Gravel	75	100
sec. 21 T 18 N R 1 E 1/4 miles E of Sidon (distance) (direction) (nearest town)			
WELL PURPOSE: (home, irrigation, municipal, industrial)			
WELL COMPLETION DATA:	Permit #		
(1) diameter (inches) 8"	MS-6W-01774		
(2) total depth (feet) 100			
(3) static water level (feet) _____ below above top of ground.			
(4) casing PVC, 60 (material), (depth) 8" (size) if telescope see back.			
(5) screen 40 (length), 60 (depth to top) 8" (size), PVC (material)			
(6) pump 7 1/2 (HP), 300 (yield gpm) Elec. (type power)			
(7) electric log No (yes or no) (organization running log)			
(8) how well bottom plugged No cap			
DRILLERS REMARKS:			

CODED

DEPARTMENT OF NATURAL RESOURCES  
 BUREAU OF LAND & WATER RESOURCES  
 MAY 20 1986

If well telescopes please sketch and show depths.

GROUND LEVEL

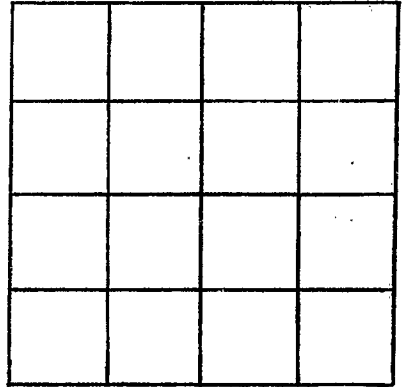

SECTION \_\_\_\_\_

Please indicate well location X.

ADDITIONAL INFORMATION

If more than one screen,  
show locations of each on sketch.