

**MISSISSIPPI DEPARTMENT OF NATURAL RESOURCES**  
 Bureau of Land and Water Resources  
 Southport Mall  
 P.O. Box 10631  
 Jackson, Mississippi 39209  
**WATER WELL DRILLERS LOG**

**CODED**

Leflore  
049

Sep. 22 19 86 Bruce Berryman Leflore  
 date well completed firm name county well located  
Greenwood.

**LANDOWNER:** Rowell Saunders  
P.O. Box 8296  
Greenwood. MS 38930.

description of formations encountered

from	to
0	30
30	60
60	130

Clay  
Sand  
Sand & Gravel

(mailing address)

**WELL LOCATION:**

sec. 12 T. 18 N R. 1 W  
S  
3 miles South of G. wood  
 (distance) (direction) (nearest town)

**CODED**

**WELL PURPOSE:** H.O.  
 (home, irrigation, municipal, industrial)

**WELL COMPLETION DATA:**

- (1) diameter (inches) 4"
- (2) total depth (feet) 130'
- (3) static water level (feet) 18' below ~~above~~ top of ground.
- (4) casing 4" P.V.C 110'  
 (material) (depth)  
         if telescope see back.  
 (size)
- (5) screen 20' 110'  
 (length) (depth to top)
- 4" .010 ga. P.V.C  
 (size) (material)
- (6) pump 1 20  
 (HP) (yield gpm)  
Electric  
 (type power)
- (7) electric log NO  
 (yes or no)  
          
 (organization running log)

**RECEIVED**

MAR 18 1987


Department of Natural Resources  
 Bureau of Land & Water Resources

(8) how well bottom plugged Cap.

**DRILLERS REMARKS:**

If well telescopes please sketch and show depths.

GROUND LEVEL

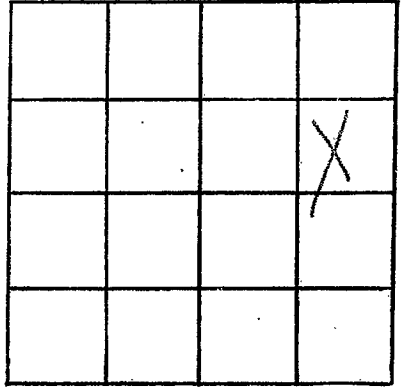

SECTION 12

Please indicate well location X.

ADDITIONAL INFORMATION

If more than one screen,  
show locations of each on sketch.