

MISSISSIPPI DEPARTMENT OF NATURAL RESOURCES

Bureau of Land and Water Resources

Southport Mall

P.O. Box 10631

Jackson, Mississippi 39209

WATER WELL DRILLERS LOG

AP-GW-8032  
 \$ 51  
 CODED

6-9-88 date well completed      Dyer Well firm name      Lefflore county well located

LANDOWNER: Mary Boyd Wood

description of formations encountered

from to

Box 236

Clay

0 30

Sidon, Ms. 38954

7 Sand

30 73

(mailing address)

Sand + Gravel

73 94

WELL LOCATION:

sec 34 T 18 N R 1 E  
 3 miles SE of Sidon  
 (distance) (direction) (nearest town)

7 Sand + Gravel

94 98

7 Sand

98 120

WELL PURPOSE: Irrigation  
 (home, irrigation, municipal, industrial)

WELL COMPLETION DATA:

- (1) diameter (inches) 10"
- (2) total depth (feet) 120'
- (3) static water level (feet) \_\_\_\_\_ below above top of ground.
- (4) casing steel (material) \_\_\_\_\_ (depth) \_\_\_\_\_  
 10" If telescope see back.  
 (size)
- (5) screen 40 (length) \_\_\_\_\_ (depth to top) \_\_\_\_\_  
 10 (size) \_\_\_\_\_ (material)
- (6) pump 1.5 (HP) \_\_\_\_\_ (yield gpm)  
 Elec (type power)
- (7) electric log No (yes or no)  
 None (organization running log)
- (8) how well bottom plugged Plate


RECEIVED  
 JUL 11 1988

Department of Natural Resources  
 Bureau of Land & Water Resources

DRILLERS REMARKS:

If well telescopes please  
sketch and show depths.

GROUND LEVEL

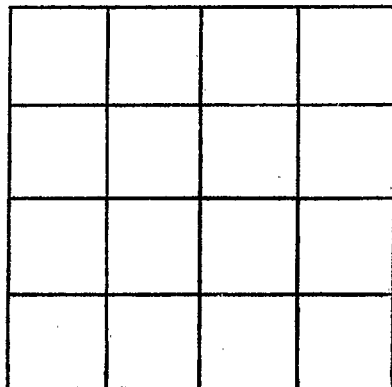

SECTION \_\_\_\_\_

Please indicate well location X.

ADDITIONAL INFORMATION

If more than one screen,  
show locations of each on sketch.