

**MISSISSIPPI DEPARTMENT OF ENVIRONMENTAL QUALITY**

Office of Land and Water Resources

P. O. Box 10631  
Jackson, MS 39289-0631

**WATER WELL DRILLERS LOG**

COUNTY WELL LOCATED <i>Leflore</i>	
WELL NUMBER	CODED
<i>db-60</i>	
DATE WELL COMPLETED <i>10-15-03</i>	

PERMIT NUMBER
NAME OF DRILLING FIRM <i>Schudco Ltd</i>

NAME & MAILING ADDRESS OF LANDOWNER <i>T. U. Black P.O. BOX 188 Sidon MS, 38954</i>			
Latitude: <i>33° 25' 01N</i> Longitude: <i>090° 10' 03W</i>			
WELL LOCATION	SEC	TOWNSHIP	RANGE
	<i>22</i>	<i>18 S</i>	<i>1 E</i>
DISTANCE	DIRECTION	NEAREST TOWN	
<i>2</i> Miles	<i>East</i>	of <i>Sidon</i>	
OTHER LANDMARK			
WELL PURPOSE: (Home, Irrigation, Municipal, Industrial, Fish Pond, etc.) <i>Farm shop + office</i>			

WELL DATA		
Well Depth <i>480</i>	Casing Diameter (In.) <i>4x2</i>	Casing Length (Ft.) <i>460</i>
Type of Casing <i>pvc</i>	Hole Depth <i>500</i>	Depth to Static Water Level <i>+3 ft</i>
TYPE OF COMPLETION: (Circle One or More): <input checked="" type="checkbox"/> Gravel Packed, <input type="checkbox"/> Underreamed, <input type="checkbox"/> Telescoped, <input checked="" type="checkbox"/> Natural Development, <input type="checkbox"/> Open Hole, <input type="checkbox"/> Other (Describe)		

WELL GROUTED TO A DEPTH OF <i>10</i> FEET Type Grout (circle one): Cement, <input checked="" type="checkbox"/> Bentonite, or Mix
---

SCREEN DATA		
Diameter - Inches <i>2</i>	Length - Feet <i>20</i>	Slot Size - Inches <i>1,008</i>
Screen Type <i>pvc</i>	Depth to Bottom - Feet <i>480</i>	

PUMP DATA		
PUMP TYPE (Circle One): <input checked="" type="checkbox"/> Submersible, <input type="checkbox"/> Turbine, <input type="checkbox"/> Jet, <input checked="" type="checkbox"/> Flowing Well		
POWER TYPE (Circle One): <input checked="" type="checkbox"/> Electric, <input type="checkbox"/> Tractor, <input type="checkbox"/> Diesel, <input type="checkbox"/> Gasoline, <input type="checkbox"/> Butane, Other (Describe) _____ H/P <i>1</i>		
DESCRIPTION OF FORMATIONS ENCOUNTERED	FROM	TO
<i>Clay</i>	<i>0</i>	<i>15</i>
<i>fine to med sand</i>	<i>15</i>	<i>60</i>
<i>course sand + p-gravel</i>	<i>60</i>	<i>140</i>
<i>sand + clay streaks</i>	<i>140</i>	<i>220</i>
<i>white sand</i>	<i>220</i>	<i>251</i>
<i>clay</i>	<i>251</i>	<i>380</i>
<i>green sand</i>	<i>380</i>	<i>420</i>
<i>med sand</i>	<i>420</i>	<i>440</i>
<i>course sand</i>	<i>440</i>	<i>480</i>
<i>shell</i>	<i>480</i>	<i>500</i>
<b>RECEIVED</b>		
<b>DEC 12 2003</b>		
<b>BY: OLWR</b>		
Top of Lap Pipe or Reduction in Casing		
FEET	IF TELESCOPED OR MORE THAN ONE SCREEN: USE BACK PAGE	

I certify that the well was drilled, constructed and completed in accordance with all applicable Requirements of the Mississippi Department of Environmental Quality and/or the Mississippi Department of Health regulations and state laws.

*Charles M. Nichols*  
Signature of Licensed Driller and License No.


*11-14-03*  
Date

*0-0667*

Additional Information Required On Back

If well telescopes please sketch and show depths.

GROUND LEVEL

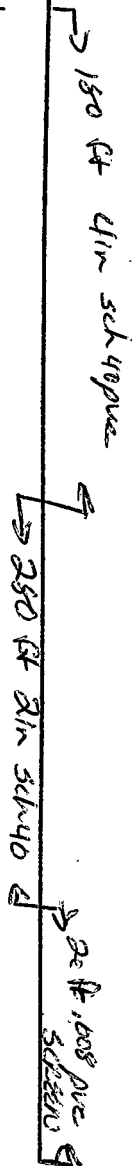

If more than one screen, show location of each on sketch.

			X

SECTION 22

Please indicate well location X.

Pump Capacity (GPM)	No. of Stages	Setting Depth
20	7	805 FT.

PUMP TEST

Well yielded \_\_\_\_\_ GPM with a drawdown of \_\_\_\_\_ ft. after \_\_\_\_\_ hours of pumping

LOG DATA

TYPE OF LOG RUN (Circle One): No Log Run  
 Electric, Gamma Ray, Density, Sonic, Neutron, Other (Describe) \_\_\_\_\_

Name of Organization Running Log \_\_\_\_\_

GEOLOGIC DATA (Office Use Only)

Surface Elev.	Geologic Unit	Unit Thickness	Depth to Top
Subs. SWL	Date	Analysis	Aquifer Test

Driller's Remarks

\_\_\_\_\_

\_\_\_\_\_

