

State Well Report

Part 1

Mississippi Department of Environmental Quality
Office of Land and Water Resources
P.O. Box 10631
Jackson, MS 39289-0631
(601)961-5210
(601)354-6938 (fax)

County: Leflore
Permit #: GW-43243
Driller: Irrigation Equipment
Date drilling completed: 5/27/09

For Office Use Only:
Aquifer: _____
Well #: φ 70
L. S. Elevation: _____
E-log #: _____

State Law requires that this report be prepared by the driller in detail and filed with the Department within 30 days of completion of drilling of the well.

Well Owner Information	Well Location
Owner Name: <u>David Howard</u>	Latitude: <u>33 ° 26 ' 18.5"</u> Longitude: <u>90 ° 14 ' 32.4"</u> ?
Mailing Address: <u>56181 county road 555</u>	Method of Lat/Long (circle one): Conventional Survey, USGS quad, Hand-held GPS, Survey-grade GPS
<u>Sidon MS 38954</u> City State Zip Code	<u>SW 1/4 NW 1/4 Sec 7 Twn 18N Rng 1E</u>
Telephone No. <u>(662) 458-0900</u>	Distance Direction Nearest Town <u>3 Miles NW of Sidon</u>

Well Data

Purpose of Well (circle one) Home Industrial Public Supply Irrigation Fish Culture Other: _____

Date well drilling started: 5/27/09 Date well drilling completed: 5/27/09

If flowing, method of flow regulation: Valve _____ Other (describe) _____

Static Water Level: 20 feet above or below (circle one) land surface Date measured: 5/27/09

Method of Measurement (circle one) steel tape electric tape air line other: _____

Hole depth: 127 Well depth: 127 Well grouted to a depth of 10 feet

Type of grout (circle one): Cement Bentonite Mix

Casing length: 87 feet Casing diameter: 16 inches Type of casing: PVC

Screen length: 40 feet Screen diameter: 16 inches Type of screen: PVC

Screen slot size: .050 inches Setting depth: From 88 feet to 127 feet

Type of completion (circle all applicable): Gravel packed Underreamed Telescoped Open hole Natural Development

Other (describe): _____

Top of lap pipe or reduction in casing: _____ feet. If telescoped or more than one screen, describe on back of page

Logs run (circle all applicable) No log run Electric Gamma Ray Density Sonic Neutron Other: _____

Name of organization running log(s): _____

I certify that the well was drilled, constructed, and completed in accordance with all applicable requirements of the Mississippi Department of Environmental Quality and/or the Mississippi Department of Health regulations and state laws.

Irrigation Equipment Inc.
John P. Chism 0439

Print Name of Water Well Contractor and License No.

John P. Chism
Signature of Water Well Contractor

RECEIVED

JUN 04 2009

BY: OLWF

STATE WELL REPORT

Part 2

Pump Installer's Completion Report
 Mississippi Department of Environmental Quality
 Office of Land and Water Resources
 P.O. Box 10631
 Jackson, MS 39289-0631
 (601)961-5210
 (601)354-6938 (fax)

County: Leflore
 Permit #: 43792
Irrigation Equipment
 Driller: _____
 Date completed: 5/27/09

For Office Use Only:

Aquifer: _____
 Well #: Ø 70
 Elevation: _____

This report should be prepared by the pump installer in detail and filed with the Department within 30 days of the installation of pump.

Well Owner Information	Well Location
Owner Name: <u>David Howard</u>	Latitude: _____ Longitude: _____
Mailing Address: <u>56181 County Road 555</u>	Method of Lat/Long (circle one): <input type="radio"/> Conventional Survey, <input type="radio"/> USGS quad, <input type="radio"/> Hand-held GPS, <input type="radio"/> Survey-grade GPS.
<u>Sidon MS 38954</u> City State Zip Code	<u>SW ¼ NW ¼ Sec 7 Twn 18N Rng 1E</u>
Telephone No. <u>(662) 458-0900</u>	Distance Direction Nearest Town <u>3 Miles NW of Sidon</u>

Pump Type Circle one	Power Type Circle one
Air Lift Jet <input type="radio"/> <input checked="" type="radio"/> Submersible	Diesel Engine Gasoline Engine Natural Gas
Bucket Piston <input type="radio"/> Turbine <input type="radio"/>	<input checked="" type="radio"/> Electric Motor Hand <input type="radio"/> Tractor PTO
Centrifugal Rotary <input type="radio"/> Flowing Well <input type="radio"/>	Windmill Other (specify): _____
Other (specify): _____	Horse Power Rating of Motor: <u>40</u>
Date Pump Installed: <u>5/27/09</u>	Setting Depth: <u>70</u> feet
Rated Pump Capacity: <u>1600 ±</u> Gallons Per Minute	Number of Stages: <u>1</u>

Pump Test Data	Method of Measuring Water Level Circle one
Date Well Tested: _____	Air Line Electric Measuring Line Steel Tape
Static Water Level (A): _____ Feet Below Land Surface	Other (specify): _____
Pumping Water Level (B): _____ Feet Below Land Surface	For flowing well, measured shut in head: _____ feet
Drawdown [(B) - (A)]: _____ Feet Below Land Surface	Well yielded _____ GPM with a drawdown of _____ feet after _____ hours of pumping
Test Pumping Rate: _____ Gallons Per Minute	
Duration of Pump Test (minimum 4 hours): _____ hours	


I HEREBY CERTIFY that the above statements are true to the best of my knowledge.

John P. Chism 0439
 Print Name of Pump Installer and License No. (if applicable)

[Signature]
 Signature of Pump Installer

RECEIVED
 JUN 04 2009
 BY: OLWR

φ 70

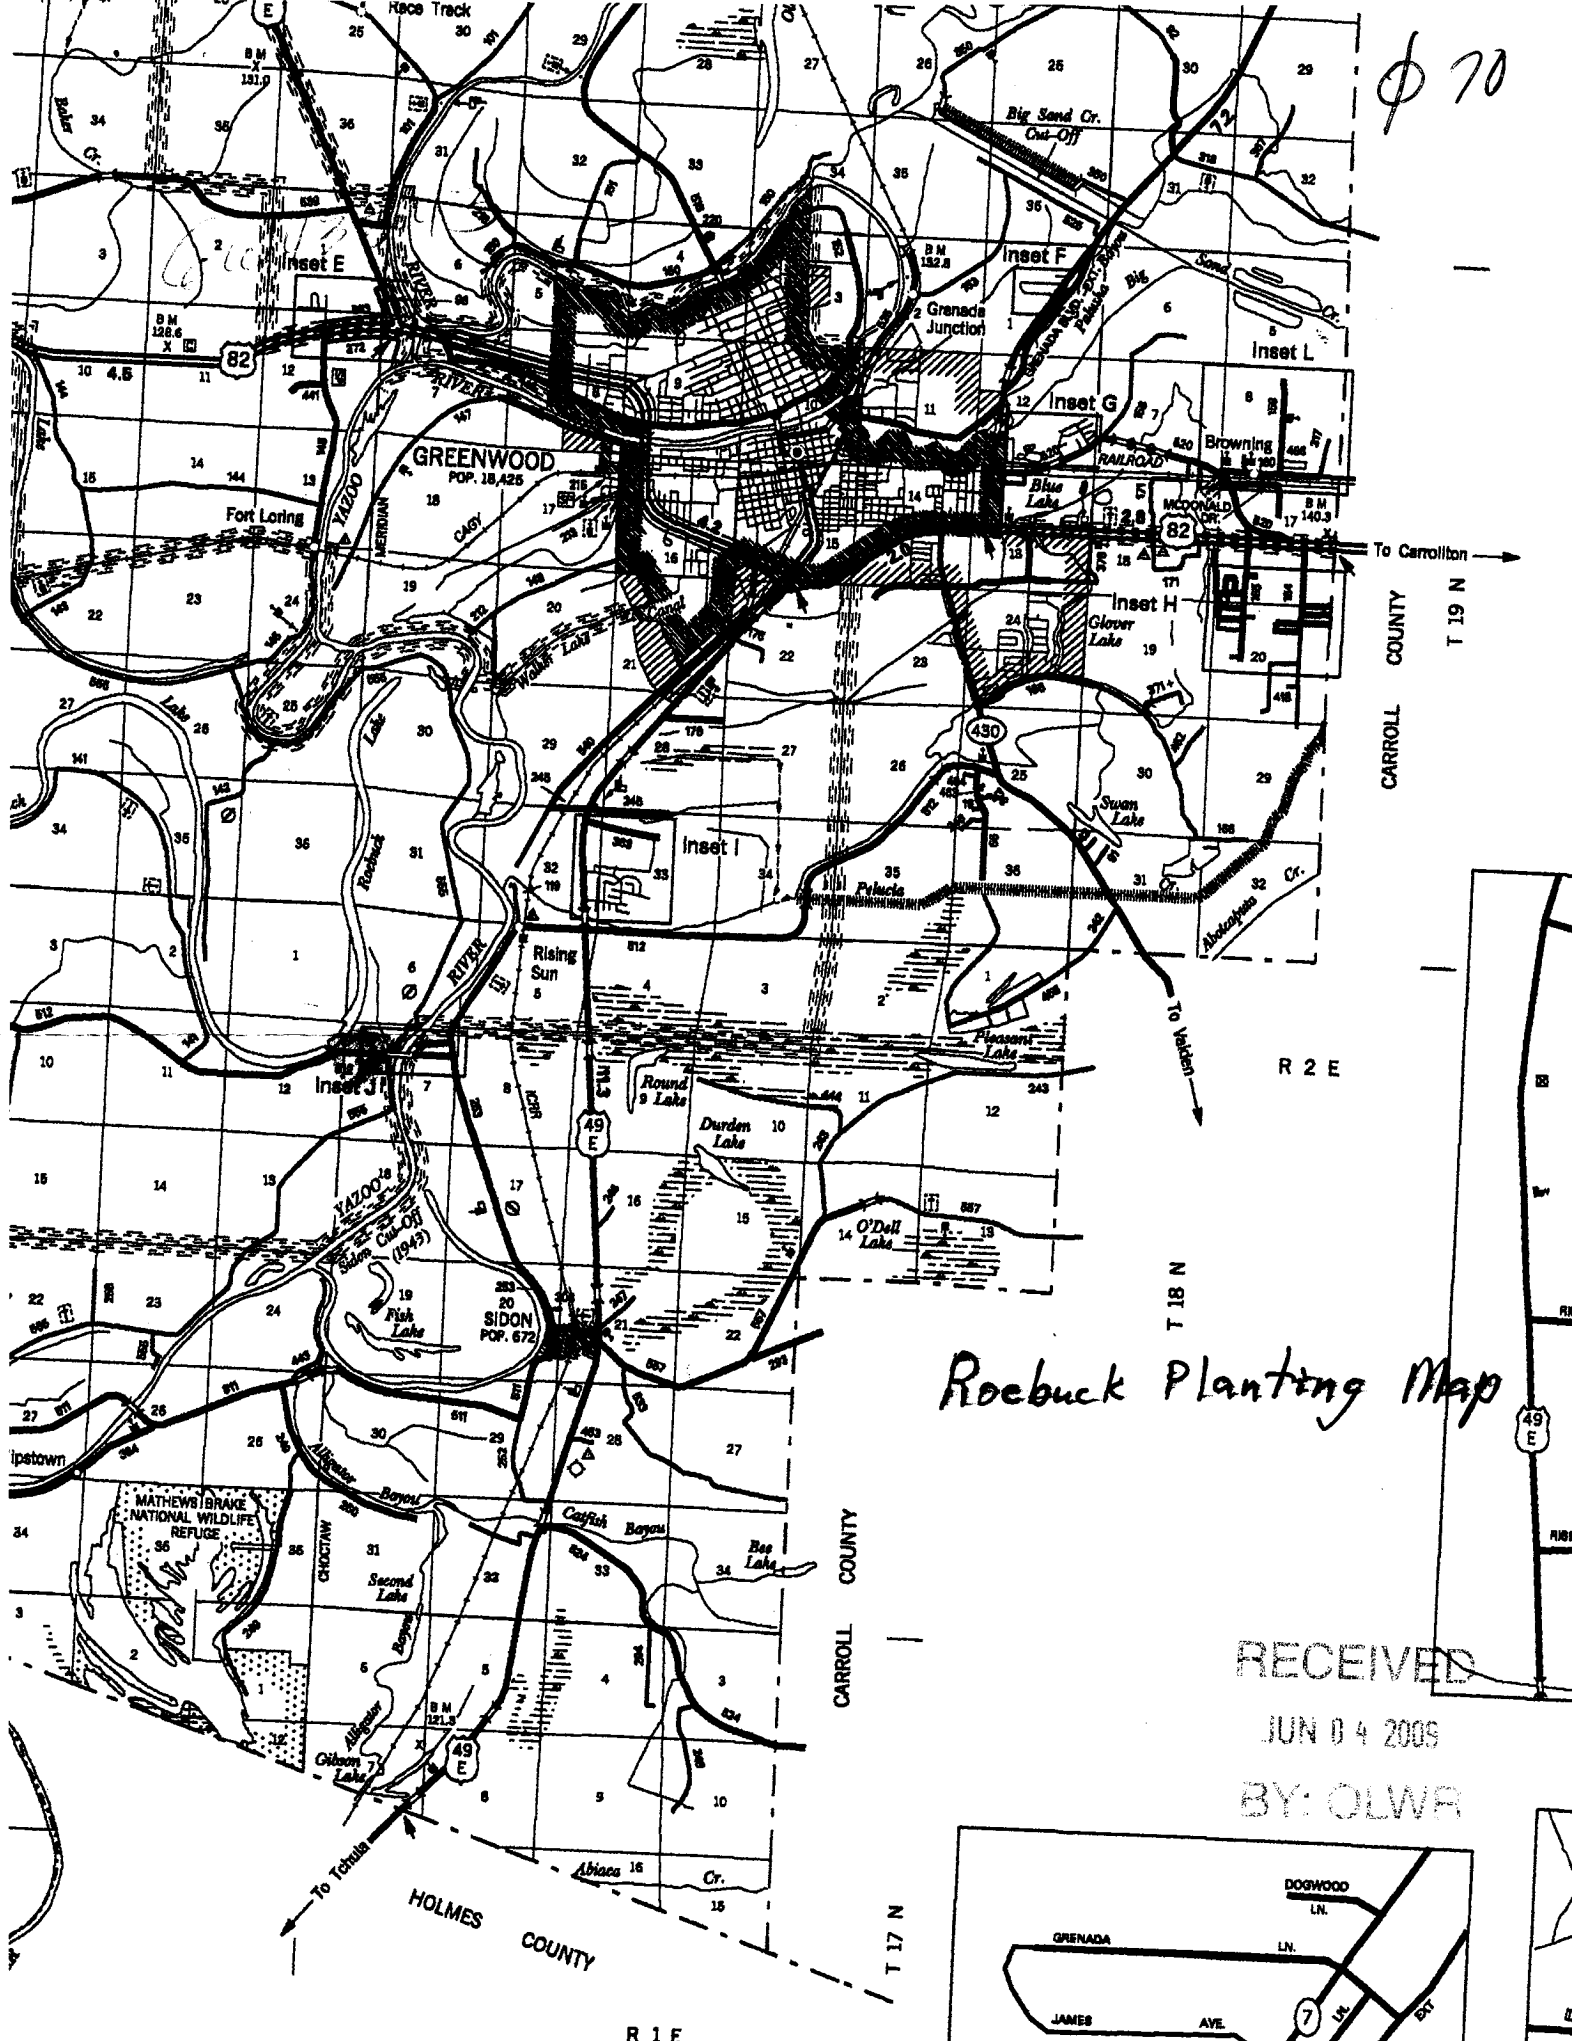


Roebuck Planting Map

RECEIVED

JUN 04 2005

BY: OLWR

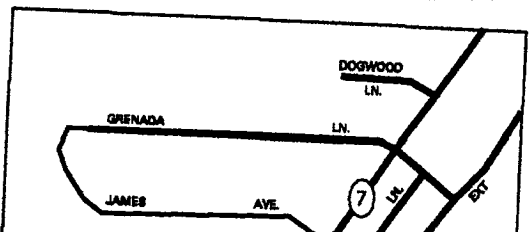

R 1 E

HOLMES COUNTY

CARROLL COUNTY

CARROLL COUNTY

T 19 N

T 18 N

R 2 E

T 17 N

To Tchula

To Jackson

To Carrollton

82

49 E

430

82

49 E

7

GREENWOOD
POP. 18,425

SIDON
POP. 672

Fort Loring

Granada Junction

Browning

Rising Sun

MATHEWS BRAKE
NATIONAL WILDLIFE
REFUGE

RECEIVED

JUN 04 2005

BY: OLWR

GREENADA LN.

DOGWOOD LN.

JAMES AVE.

7

RISING

RFD

BY

IB

IB

