

MISSISSIPPI
BOARD OF WATER COMMISSIONERS
416 North State Street
Jackson, Mississippi 39201

CODED

WATER WELL DRILLERS LOG

CODED

LEFLORE
Ø97
6-27-68

6-27 1968 Dyer Well Dr. Leflore
date well completed firm name county well located

LANDOWNER:

CAL-MISS CO.

description of formations encountered

from to

Siron, Miss.
(mailing address)

<u>SANDY SOIL</u>	<u>0</u>	<u>14</u>
<u>BENE CLAY</u>	<u>14</u>	<u>23'</u>
<u>HARD BROWN CLAY</u>	<u>23</u>	<u>34</u>
<u>SOFT BENE CLAY</u>	<u>34</u>	<u>39</u>
<u>MED. SAND</u>	<u>39</u>	<u>44</u>
<u>MED. SAND & GRA.</u>	<u>44</u>	<u>53</u>
<u>"</u>	<u>53</u>	<u>63</u>
<u>COARSE SAND & GRA</u>	<u>63</u>	<u>103</u>

WELL LOCATION:

sec 30 T 18 N R 1 E
2 miles WEST of SIRON
(distance) (direction) (nearest town)


WELL PURPOSE:

IND.
(home, irrigation, municipal, industrial)

WELL COMPLETION DATA:


- (1) diameter (inches) 12"
- (2) total depth (feet) 103'
- (3) static water level (feet) 16' below above top of ground.
- (4) casing BUTR 71',
(material) (depth),
12" if telescope see back.
(size)
- (5) screen 32', 71'
(length) (depth to top)
12", BUR INGOI
(size) (material)
- (6) pump 33 1800
(HP) (yield gpm)
BRITAIN
(type power)
- (7) electric log NO
(yes or no)
(organization running log)
- (8) how well bottom plugged PLATE

DRILLERS REMARKS:

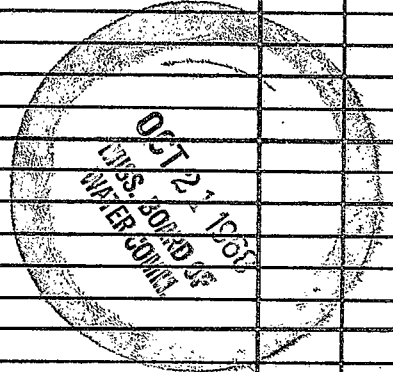

If well telescopes please sketch and show depths.

GROUND LEVEL

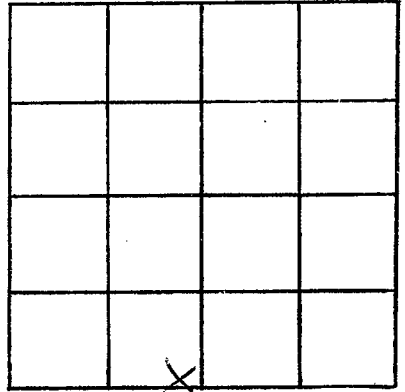

SECTION 30

Please indicate well location X.

ADDITIONAL INFORMATION

If more than one screen, show locations of each on sketch.