

*Leflore*  
 O 98  
 6-13-69

MISSISSIPPI  
 BOARD OF WATER COMMISSIONERS  
 416 North State Street  
 Jackson, Mississippi 39201

CODED

WATER WELL DRILLERS LOG

6-13-69 19 DYER WELL & IRRIGATION SERVICE LEFLORE  
 date well completed firm name county well located

LANDOWNER:  
 M. B. M' CARTY

ITTA BENA, MISS.  
 (mailing address)

WELL LOCATION:  
 sec. 18 T. 18 N R. 1 E  
 4 miles S.W. of ITTA BENA  
 (distance) (direction) (nearest town)

WELL PURPOSE: IRRIGATION  
 (home, irrigation, municipal, industrial)

- WELL COMPLETION DATA:
- (1) diameter (inches) 12"
  - (2) total depth (feet) 103'
  - (3) static water level (feet) 18' below top of ground.
  - (4) casing BK IR 63' (material) (depth)  
 12" (size) If telescope see back.
  - (5) screen 40' 63' (length) (depth to top)  
 12" BK INGT (size) (material)
  - (6) pump 28 1650 (HP) (yield gpm)  
 BUTANE (type power)
  - (7) electric log No (yes or no)
  - (organization running log)
  - (8) how well bottom plugged PLATE

description of formations encountered	from	to
Clay + fine sand	0	13
Blue clay ✓	13	23
Fine sand	23	33
Med. sand	33	43
Coarse sand	43	53
✓ ✓ Gravel	53	63
✓ ✓ ✓	63	73
✓ ✓ ✓	73	83
✓ ✓ ✓	83	93
✓ ✓ ✓	93	103


DRILLERS REMARKS:

1111 23 1969

MISS. BU. OF WATER COMMISSIONERS

If well telescopes please sketch and show depths.

GROUND LEVEL

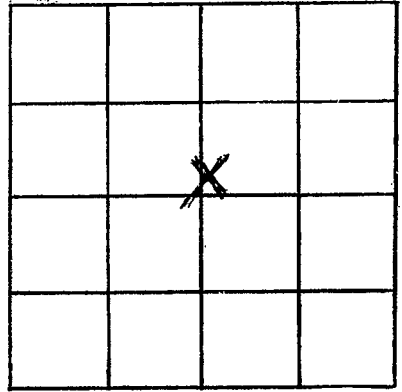

SECTION 18

Please indicate well location X.

ADDITIONAL INFORMATION

If more than one screen, show locations of each on sketch.