

Leflore Co
 099
 5-11-70

MISSISSIPPI
 BOARD OF WATER COMMISSIONERS
 416 North State Street
 Jackson, Mississippi 39201

E-log # 79

CODED

WATER WELL DRILLERS LOG

5-11
 date well completed

1970 Layne-Central Co.
 firm name

Leflore
 county well located

LANDOWNER:
Town of Sidon
Sidon, Miss.
 (mailing address)

WELL LOCATION:
 sec. 21 T. 18 N R. 1 E
 (distance) miles (direction) of (nearest town)

WELL PURPOSE: Municipal
 (home, irrigation, municipal, industrial)

WELL COMPLETION DATA:

(1) diameter (inches) 10"

(2) total depth (feet) 954'

(3) static water level (feet) flow below above top of ground.

(4) casing Gal 900'
 (material) (depth)

10" if telescope see back. and
 (size) 44' x 8"

(5) screen 42' 908'
 (length) (depth to top)

8" Stainless Steel
 (size) (material)

(6) pump _____ (HP) _____ (yield gpm)
Electric
 (type power)

(7) electric log Yes
 (yes or no)
Miss. Geo. Survey
 (organization running log)

(8) how well bottom plugged Slugs

description of formations encountered	from	to
Clay	0	15
Sandy Clay	15	40
Sand, streaks of Clay	40	80
Sand, and Gravel	80	134
Clay, streaks of Sand	134	156
Fine Sand	156	245
Clay	245	250
Sand, mixed with Clay	250	365
Hard Shale	365	455
Rock	455	457
Shale, streaks of Sand	457	565
Rock	565	566
Shale	566	585
Rock	585	587
Sand, streaks of Shale	587	736
Sand	736	744
Sand, streaks of Shale	744	825
Sand	825	834
Shale, streaks of Sand	834	846
Sand, streaks of Shale	846	900
Sand	900	954

CODED

MAY 15 1970

MISS. BD. OF
 WATER COM.


DRILLERS REMARKS:

Pump not installed as of this date

Mailed to Board of Water Commissioners 5/14/70

If well telescopes please sketch and show depths.

GROUND LEVEL

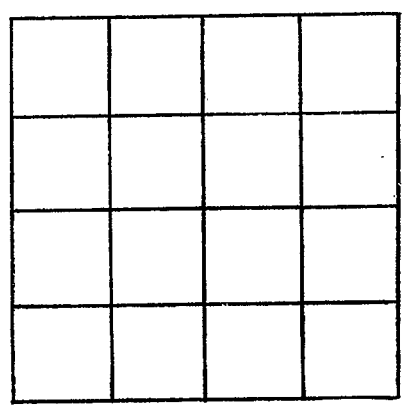

SECTION _____

Please indicate well location X.

ADDITIONAL INFORMATION

A series of horizontal lines for recording additional information.

If more than one screen, show locations of each on sketch.