

MISSISSIPPI DEPARTMENT OF NATURAL RESOURCES

Bureau of Land and Water Resources

COUNTY WELL LOCATED <i>Wetlowe</i>	
WELL NUMBER <i>Q126</i>	CODED
DATE WELL COMPLETED <i>12-20-88</i>	

PERMIT NUMBER
NAME OF DRILLING FIRM BUTANE GAS CO. OF GREENWOOD

CODED

P.O. Box 10631
Jackson, Mississippi 39209
WATER WELL DRILLERS LOG

NAME & MAILING ADDRESS OF LANDOWNER <i>Willis McGary</i>		
WELL LOCATION: SEC TOWNSHIP RANGE		
<i>21 18 N 1 E</i>		
DISTANCE	DIRECTION	NEAREST TOWN
<i>1/4</i> Miles	<i>N</i>	of <i>Sidow</i>
OTHER LANDMARK		
WELL PURPOSE: Home, Irrigation, Municipal, Industrial, Fish Pond, etc. <i>Irrigation</i>		

PUMP DATA		
PUMP TYPE (Circle One): Submersible, <u>Turbine</u> , Jet, Flowing Well, Other (Describe) _____		
POWER TYPE (Circle One): Electric, Tractor, <u>Diesel</u> , Gasoline, Butane, Other (Describe) _____ H/P _____		
Pump Capacity (GPM) <i>1600</i>	No. of Stages <i>4</i>	Setting Depth <i>60</i> FT.
PUMP TEST		
Well yielded _____ GPM with a drawdown of _____ ft. after _____ hours of pumping		

WELL DATA		
Well Depth <i>105</i>	Casing Diameter (In.) <i>16</i>	Casing Length (Ft.) <i>65</i>
Type of Casing <i>Steel</i>	Hole Depth <i>105</i>	Depth to Static Water Level <i>25</i>
TYPE OF COMPLETION: (Circle One or More): <u>Gravel Packed</u> , Underreamed, Telescoped, Natural Development, Open Hole, Other (Describe) _____		
Top of Lap Pipe or Reduction in Casing		
FEET IF TELESCOPED OR MORE THAN ONE SCREEN: USE BACK PAGE		

LOG DATA	
TYPE OF LOG RUN (Circle One): Electric, Gamma Ray, Density, Sonic, Neutron, Other (Describe) _____	
<u>No Log Run</u>	
Name of Organization Running Log	

SCREEN DATA		
Diameter - Inches <i>16</i>	Length - Feet <i>40</i>	Slot Size - Inches <i>.030</i>
Screen Type <i>wire wrapped</i>	Depth to Bottom - Feet <i>105</i>	

GEOLOGIC DATA (Office Use Only)			
Surface Elev.	Geologic Unit	Unit Thickness	Depth to Top
Subs. SWL	Date	Analysis	Aquifer Test


Driller's Remarks

DESCRIPTION OF FORMATIONS ENCOUNTERED	FROM	TO
<i>Clay</i>	<i>0</i>	<i>20</i>
<i>Sand</i>	<i>20</i>	<i>40</i>
<i>Sand & Peat Gravel</i>	<i>40</i>	<i>105</i>

FORMATIONS (Continued)	FROM	TO
RECEIVED		
DEC 28 1988		
Department of Natural Resources Bureau of Land & Water Resources		
IF MORE SPACE IS NEEDED, USE BACK		

If well telescopes please sketch and show depths.

GROUND LEVEL

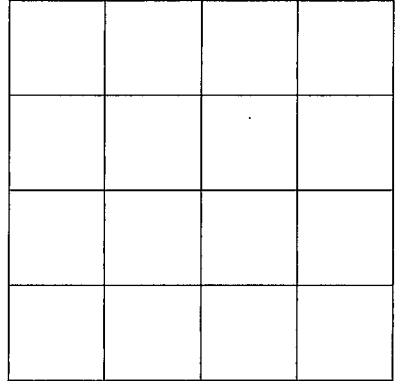

SECTION 21

Please indicate well location X.

ADDITIONAL INFORMATION

If more than one screen,
show location of each on sketch.