

LEFLORE
0
02-27-79
2000

**MISSISSIPPI
BOARD OF WATER COMMISSIONERS**
416 North State Street
Jackson, Mississippi 39201
WATER WELL DRILLERS LOG

February 27 1979 Bruce Berryman - LEFLORE
 date well completed firm name county well located
 Greenwood

LANDOWNER: Bell Chapel	description of formations encountered	from	to
c/o Mr. E.J. Smith			
Sidon, Miss. 38954 (mailing address)	Clay	0	20
	Sand	20	60
	Sand & Gravel	60	140
	Clay	140	160
	Sand	160	200
	Clay	200	220
	Sand	220	400
	Shale & Str. sand	400	460
	Shale	460	560
	Shale & rocks	560	580
	Sand	580	600

WELL LOCATION:
 sec. 7 T 17 N R 1 E
 S S
 5 miles S of Sidon
 (distance) (direction) (nearest town)

WELL PURPOSE: Church
 (home, irrigation, municipal, industrial)

WELL COMPLETION DATA:

(1) diameter (inches) 2 1/2

(2) total depth (feet) 400'

(3) static water level (feet) 5' below top of ground. ~~305.5'~~

(4) casing 2" Galv. / 390' (material) (depth)
 (size) if telescope see back.

(5) screen 10' 390' (length) (depth to top)
 2" 304 Stainless steel (size) (material)

(6) pump 1/2 h.p. 10 (HP) (yield gpm)
 Electric (type power)

(7) electric log No (yes or no)
 (organization running log)

(8) how well bottom plugged B.P.V.

Miss. Board of Water Comm.


MAY - 8 1979

RECEIVED

DRILLERS REMARKS:

If well telescopes please sketch and show depths.

GROUND LEVEL

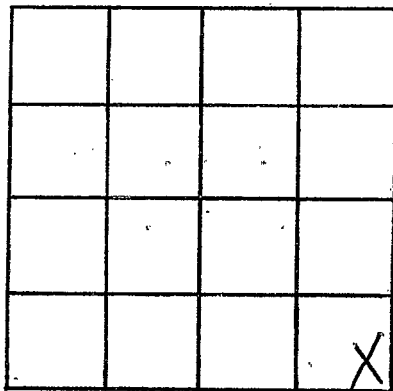

SECTION 7

Please indicate well location X.

ADDITIONAL INFORMATION

If more than one screen,
show locations of each on sketch.