

*Lefflore*  
*D. 2001*  
*9-3-76*

MISSISSIPPI  
 BOARD OF WATER COMMISSIONERS  
 416 North State Street  
 15J Jackson, Mississippi 39201

WATER WELL DRILLERS LOG

MIAMI GAS CO. OF GREENWOOD

9-3-76  
 date well completed

19

firm name

*Lefflore*  
 county well located

| LANDOWNER:   | description of formations encountered | from       | to         |
|--|---------------------------------------|------------|------------|
| <i>George Moore</i>  |                                       |            |            |
| <i>Sidon</i>   | <i>SAND</i>                           | <i>10</i>  | <i>50</i>  |
| (mailing address)  | <i>SAND + GRAVEL</i>                  | <i>50</i>  | <i>140</i> |
| WELL LOCATION:   | <i>SAND</i>                           | <i>140</i> | <i>210</i> |
| sec. <i>14</i> T. <i>18</i> N. R. <i>1</i> E   | <i>CLAY</i>                           | <i>210</i> | <i>320</i> |
| <i>3</i> miles <i>NE</i> of <i>Sidon</i>   | <i>SHALE</i>                          | <i>320</i> | <i>500</i> |
| (distance) (direction) (nearest town)  | <i>SAND</i>                           | <i>500</i> | <i>655</i> |
| WELL PURPOSE: <i>Home</i>  | <i>SHALE</i>                          | <i>655</i> | <i>680</i> |
| (home, irrigation, municipal, industrial)  | <i>SAND</i>                           | <i>680</i> | <i>750</i> |
| WELL COMPLETION DATA:  |                                       |            |            |
| (1) diameter (inches) <i>4 1/2</i>   |                                       |            |            |
| (2) total depth (feet) <i>740</i>  |                                       |            |            |
| (3) static water level (feet) <i>10</i> <sup>below</sup> / <sub>above</sub> top of ground. |                                       |            |            |
| (4) casing <i>PVC</i> , <i>720</i> ,<br>(material) (depth)                                 |                                       |            |            |
| <i>4 1/2</i> If telescope see back.<br>(size)  |                                       |            |            |
| (5) screen <i>20'</i> , <i>720</i><br>(length) (depth to top)                              |                                       |            |            |
| <i>2"</i> , <i>Strawles S</i><br>(size) (material)   |                                       |            |            |
| (6) pump <i>1/3</i> , <i>10</i><br>(HP) (yield gpm)  |                                       |            |            |
| <i>Elec.</i><br>(type power)   |                                       |            |            |
| (7) electric log <i>No</i><br>(yes or no)  |                                       |            |            |
| (organization running log)   |                                       |            |            |
| (8) how well bottom plugged <i>Lead Plug</i>   |                                       |            |            |
| DRILLERS REMARKS:  |                                       |            |            |

RECEIVED

SEP - 7 1976

MISS. BD. OF WATER COM.


If well telescopes please sketch and show depths.

GROUND LEVEL

100' - 4" CASING →

620' - 2" CASING →

20' - 2" SCREEN →

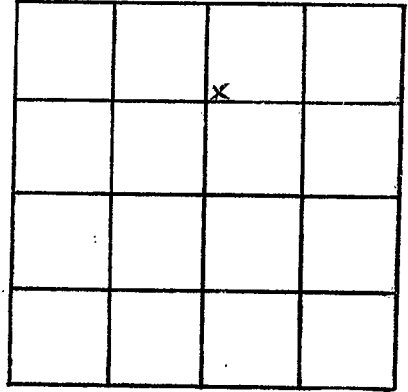

SECTION 14

Please indicate well location X.

ADDITIONAL INFORMATION

If more than one screen, show locations of each on sketch.