

Leflore
2003
5/27/77

MISSISSIPPI
 BOARD OF WATER COMMISSIONERS
 416 North State Street
 Jackson, Mississippi 39201

WATER WELL DRILLERS LOG

May 27 1977 Bruce Berryman - LEFLORE
 date well completed firm name county well located
 Greenwood, Miss.

LANDOWNER: Glenn Miller	description of formations encountered	from	to
500 W. Park Avenue,	Clay	0	40
Greenwood, Miss.	Sand & gravel	40	100
(mailing address)	Clay	100	140
WELL LOCATION:	Sand	140	160
sec. 4 T. 17N R. 1E	Clay	160	200
3 miles SE of SIDON	Sand	200	220
(distance) (direction) (nearest town)	Clay	220	230
WELL PURPOSE:	Sand	230	310
(home, irrigation, municipal, industrial)	Shale	310	440
WELL COMPLETION DATA:	Rock & shale	440	460
(1) diameter (inches) 4" x 2"	Shale & Str. sand	460	500
(2) total depth (feet) 580ft	Sand	500	520
(3) static water level (feet) Flowing below top of ground	Shale	520	545
(4) casing 4" blk. - 105'	Sand	545	580
2" galv. - 455'	Shale	580	590
(material) (depth)			
(size) If telescope see back.			
(5) screen 20' 560'			
(length) (depth to top)			
.010 Stainless steel			
(size) (material)			
(6) pump No pump set.			
(HP) (yield gpm)			
(type power)			
(7) electric log NO			
(yes or no)			
(organization running log)			
(8) how well bottom plugged B.P.V			
DRILLERS REMARKS:			


RECEIVED

SEP 16 1977

MISSISSIPPI BOARD OF WATER COMMISSIONERS

If well telescopes please sketch and show depths.

GROUND LEVEL

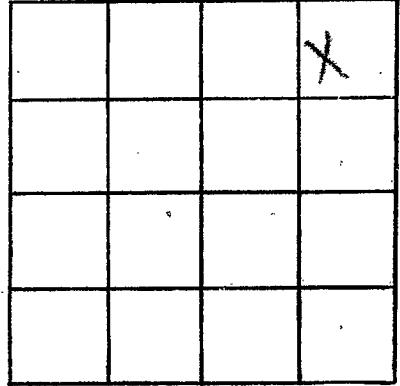

SECTION 4

Please indicate well location X.

ADDITIONAL INFORMATION

If more than one screen, show locations of each on sketch.