

*LeBlanc*  
 2005  
 1-29-76

MISSISSIPPI  
 BOARD OF WATER COMMISSIONERS  
 416 North State Street  
 Jackson, Mississippi 39201

WATER WELL DRILLERS LOG

*LeBlanc*  
 Holmes


Jan. 29 1976 Bruce Berryman  
 date well completed Greenwood county well located

LANDOWNER:	description of formations encountered	from	to
Mr. Thad Johnson	Clay	0	20
R.R. Cruger,	Sand	20	40
Mississippi.	Sand & Gravel	40	100
(mailing address)	Sand	100	140
WELL LOCATION:	Clay	140	220
sec. 4 T 17 N R 1 E	Sand	220	380
6 miles SE of SIDON	Clay	380	500
(distance) (direction) (nearest town)	Shale	500	560
WELL PURPOSE: Home	Clay	560	582
(home, irrigation, municipal, industrial)	Green sand	582	594
WELL COMPLETION DATA:			
(1) diameter (inches) 2"			
(2) total depth (feet) 592 ft.			
(3) static water level (feet) flow <sup>below</sup> above top of ground.			
(4) casing 2" galv. 582 ft. (material) (depth)			
(size) If telescope see back.			
(5) screen 10 ft. 582 ft. (length) (depth to top)			
.010 stainless steel (size) (material)			
(6) pump Did not supply pump (HP) (yield gpm)			
(type power)			
(7) electric log No (yes or no)			
(organization running log)			
(8) how well bottom plugged B.P.V.			
DRILLERS REMARKS:			

RECORDED  
 MAY 18 1976

If well telescopes please sketch and show depths.

GROUND LEVEL

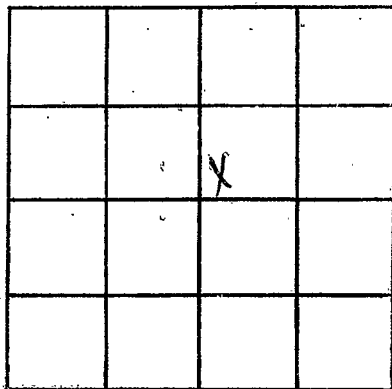

SECTION 4

Please indicate well location X.

ADDITIONAL INFORMATION

If more than one screen, show locations of each on sketch.