

MISSISSIPPI DEPARTMENT OF NATURAL RESOURCES

Bureau of Land and Water Resources

Southport Mall

P.O. Box 10631

Jackson, Mississippi 39209

WATER WELL DRILLERS LOG

LEFLORE
⊙
2007

6-2-86 19 BUTANE GAS CO. OF GREENWOOD Leflore
 date well completed firm name county well located


LANDOWNER:	description of formations encountered	from	to
Scott Wooten			
Sidon, Miss. (mailing address)	CLAY	0	25
	Fine SAND	25	60
	SAND + GRAVEL	60	105
WELL LOCATION:			
sec <u>21</u> T <u>18</u> N R <u>1</u> E S W			
<u>1/4</u> miles <u>E</u> of <u>Sidon</u> (distance) (direction) (nearest town)			
WELL PURPOSE: <u>Home</u> (home, irrigation, municipal, industrial)			
WELL COMPLETION DATA:			
(1) diameter (inches) <u>4"</u>			
(2) total depth (feet) <u>105</u>			
(3) static water level (feet) <u>20</u> below top of ground.			
(4) casing <u>PVC</u> , <u>85</u> (material), (depth), <u>4"</u> (size) if telescope see back.			
(5) screen <u>20</u> , <u>85</u> (length), (depth to top) <u>4"</u> , <u>PVC</u> (size), (material)			
(6) pump <u>1/2</u> <u>40</u> (HP) (yield gpm) <u>Elec.</u> (type power)			
(7) electric log <u>No</u> (yes or no)			
(organization running log)			
(8) how well bottom plugged <u>Back Pressure Valve</u>			
DRILLERS REMARKS:			

RECEIVED
 JUN 03 1986

MISSISSIPPI DEPARTMENT OF NATURAL RESOURCES
 BUREAU OF LAND AND WATER RESOURCES

If well telescopes please sketch and show depths.

GROUND LEVEL

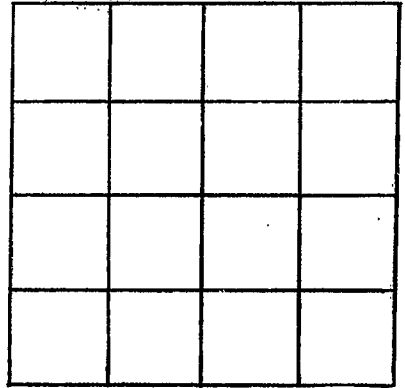

SECTION 21

Please indicate well location X.

ADDITIONAL INFORMATION

If more than one screen,
show locations of each on sketch.