

MISSISSIPPI DEPARTMENT OF ENVIRONMENTAL QUALITY
Office of Land and Water Resources
P. O. Box 2309
Jackson, MS 39225
Water Well Plugging/Decommissioning Form
OLWR-DF-1 (04/08)

COUNTY WELL LOCATED: Leflore		WELL NUMBER:
PERMIT NUMBER: GW-12538	DATE WELL PLUGGED: 4-3-2021	
NAME OF FIRM PLUGGING WELL: Chicot Irrigation Inc.	TELEPHONE NUMBER: 662-887-2555	
NAME AND ADDRESS OF CURRENT LANDOWNER: John Beckham 8752 Monte Carlo Cove Germantown TN 38139		
WELL LOCATION:	SECTION: 9	TOWNSHIP: 16N RANGE: 2W
WELL LOCATION: LATITUDE: 33 15 59.2	LONGITUDE: 90 24 34.7	METHOD (CIRCLE ONE): (1) USGS QUAD (2) CONVENTIONAL SURVEY (3) GPS - HAND HELD OR SURVEY GRADE
DISTANCE:	DIRECTION:	NEAREST TOWN: Swifttown
OTHER LANDMARK:		
WELL PURPOSE (HOME, IRRIGATION, MUNICIPAL, ETC.): Irrigation		
NAME OF WELL CONTRACTOR WHO DRILLED THE WELL:		
NAME OF LANDOWNER WHEN WELL WAS DRILLED:		


WELL DATA		
WELL DEPTH: 98Ft.	HOLE DEPTH:	
CASING DIAMETER (IN.): 12	CASING LENGTH (FT.):	TYPE OF CASING: Steel
DEPTH TO STATIC WATER LEVEL: 20Ft.	DATE WELL COMPLETED:	
WHY IS THE WELL BEING ABANDONED? Replaced		

DESCRIBE HOW THE WELL OR HOLE WAS PLUGGED (AMOUNT OF CASING AND/OR SCREEN THAT WAS REMOVED OR LEFT IN HOLE, MATERIAL AND AMOUNT USED IN PLUGGING, METHOD OF PLACING MATERIAL, ETC.)


Removed casing below ground level. Installed 5% chlorine bleach. Installed sand and gravel. Installed bentonite hole plug.

New Well: GW-51525

I CERTIFY THAT THE WELL WAS PLUGGED OR ABANDONED IN ACCORDANCE WITH THE STATE OF MISSISSIPPI REGULATIONS.

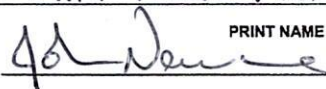JOHN NEWCOME	0-773
	MS LICENSE NUMBER
SIGNATURE	5-12-2021
	DATE

RECEIVED
JUN 14 2021
BY OLWR

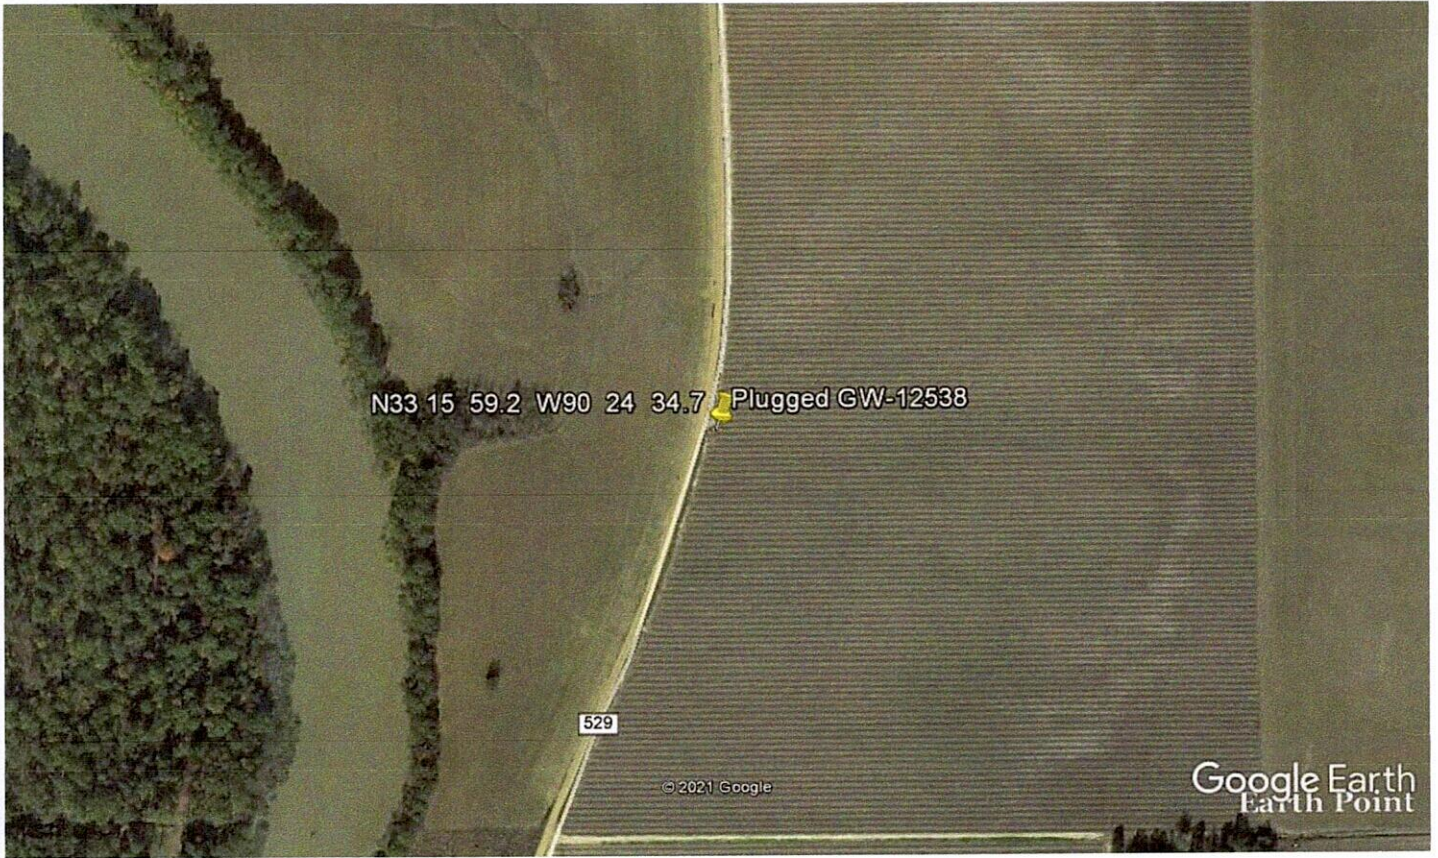

Google Earth

feet
meters



RECEIVED
JUN 14 2021
BY OLWR