

LeFlore

P2

2-15-73

MISSISSIPPI
 BOARD OF WATER COMMISSIONERS
 416 North State Street
 Jackson, Mississippi 39201

WATER WELL DRILLERS LOG

2-15-73

BUTANE GAS CO. OF GREENWOOD

LeFlore

date well completed

firm name

county well located

LANDOWNER:

J.W. Aust

Swiftown

(mailing address)

WELL LOCATION:

sec. 21 T 17 N R 2 E

1 miles NE of Swiftown (distance) (direction) (nearest town)

WELL PURPOSE: Home (home, irrigation, municipal, industrial)

WELL COMPLETION DATA:

(1) diameter (inches) 4 1/2

(2) total depth (feet) 1374

(3) static water level (feet) 46 below top of ground.

(4) casing Steel, 1344 (material) (depth)

4 1/2 (size) if telescope see back.

(5) screen 30, 1344 (length) (depth to top)

2" Stainless (size) (material)

(6) pump none, 50 (HP) (yield gpm)

none (type power)

(7) electric log no (yes or no)

(organization running log)

(8) how well bottom plugged Lead Plug

description of formations encountered

from to

Clay	0	10
SAND	10	80
SAND + GRAVEL	80	150
Clay	150	270
SAND + SHALE	270	475
SAND	475	750
Clay	750	900
SHALE	900	975
SAND + SHALE	975	1295
Clay	1295	1320
SAND	1320	1374

CODE

FEB 20 1973

DRILLERS REMARKS:


If well telescopes please sketch and show depths.

GROUND LEVEL

105' - 4" Casing →

1239' - 2" Casing →

30' - 2" Screen →

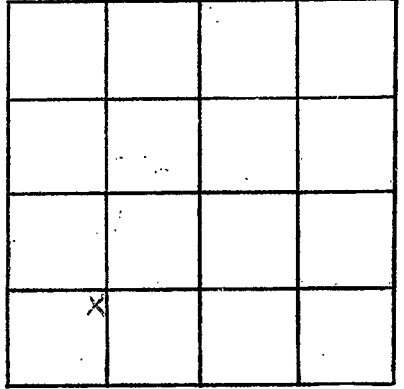

SECTION VI

Please indicate well location X.

ADDITIONAL INFORMATION

If more than one screen, show locations of each on sketch.