

Leflore
 P3
 9-67
 Elec log #70


MISSISSIPPI
 BOARD OF WATER COMMISSIONERS
 416 North State Street
 Jackson, Mississippi 39201

CODED

WATER WELL DRILLERS LOG

SEPT. 26, 1967 date well completed
 DELTA DRILLING Co. firm name
 LEFLORE county well located

LANDOWNER: SID PEEBLES	description of formations encountered	from	to
MORGAN CITY, MISS (mailing address)			
WELL LOCATION: NW/4 NE/4 NW/4 sec. 4 T17 N R. 2 E W 5 miles SW of Morgan City (distance) (direction) (nearest town)	gumbo	0	20
WELL PURPOSE: DOMESTIC (home, irrigation, municipal, industrial)	sand	20	61
WELL COMPLETION DATA:	gravel	61	82
(1) diameter (inches) 3	SAND	82	146
(2) total depth (feet) 1404	gumbo	146	288
(3) static water level (feet) FLOW below top of ground.	Sand	288	327
(4) casing STEEL, 1384 (material) (depth)	gumbo	327	462
2 1/2" if telescope see back. (size)	sand	462	684
(5) screen 20', 1384 (length) (depth to top)	gumbo	684	777
2" S. STEEL (size) (material)	Shale	777	835
(6) pump (HP) 60 (yield gpm)	SAND w/ROCK	835	913
(type power)	SHALE	913	932
(7) electric log YES (yes or no)	sand	932	971
U.S. GEOLOGICAL SURVEY (organization running log)	Shale	971	1108
(8) how well bottom plugged BACK PRESSURE VALVE	Sand	1108	1228
DRILLERS REMARKS: 2 1/2" PRESSURE	Shale	1228	1207
	gumbo	1207	1227
	BROWN Shale	1227	1286
	Shale	1286	1305
	Sand	1305	1402
	gumbo	2	1404

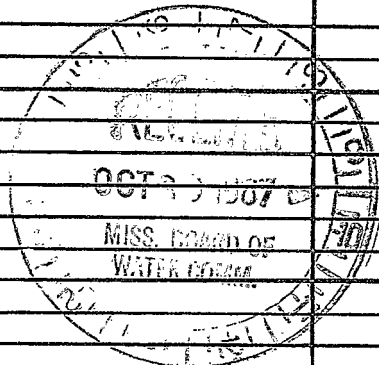

If well telescopes please sketch and show depths.

GROUND LEVEL

150' - 3" BLK PIPE

20' LAP OF 2" IN 3" PIPE

654' - 2" BLK PIPE

20' - 2 1/2" S.S. SCREEN

SECTION _____

Please indicate well location X.

ADDITIONAL INFORMATION

If more than one screen, show locations of each on sketch.