

CODED

6/13/69
Ja
02799

MISSISSIPPI
BOARD OF WATER COMMISSIONERS
416 North State Street
Jackson, Mississippi 39201

WATER WELL DRILLERS LOG

Leflore
P4
523-69

May 23, 19 69 Layne-Central Company Leflore
date well completed firm name county well located

LANDOWNER: Mississippi State
Game & Fish Commission

description of formations
encountered

from to

Clay 0 47
Coarse sand, pea gravel 47 70
Coarse sand, pea gravel
and gravel 70 104

St. Jackson, Mississippi
(mailing address)

WELL LOCATION:

sec. 16 T 16 N R 2 Ex
XX W
miles of
(distance) (direction) (nearest town)

WELL PURPOSE: irrigation
(home, irrigation, municipal, industrial)

WELL COMPLETION DATA:

- (1) diameter (inches) 16
- (2) total depth (feet) 104
- (3) static water level (feet) 9' 3" ~~below~~ above
top of ground.
- (4) casing steel 54'
(material) (depth)
16" if telescope see back.
(size)
- (5) screen 50' 104'
(length) (depth to top)
16" Armco
(size) (material)
- (6) pump 60 3000
(HP) (yield gpm)
electric
(type power)
- (7) electric log no
(yes or no)
(organization running log)
- (8) how well bottom plugged plate


JUN 17 1969

MISS. Bd. OF
WATER COM.

DRILLERS REMARKS:

If well telescopes please sketch and show depths.

GROUND LEVEL

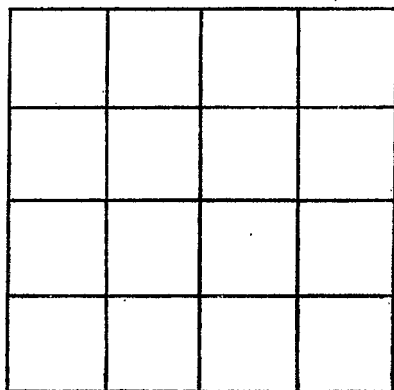

SECTION _____

Please indicate well location X.

ADDITIONAL INFORMATION

If more than one screen,
show locations of each on sketch.