

LEFLORE

P 22

11-13-73

MISSISSIPPI
 BOARD OF WATER COMMISSIONERS
 416 North State Street
 Jackson, Mississippi 39201

CODED

WATER WELL DRILLERS LOG

11/13 date well completed

1973 DYER WELL & IRRIGATION SERVICE firm name

LEFLORE

County well located

LANDOWNER: Derwood STRAIN

MORGAN CITY

Miss.

(mailing address)

description of formations encountered

from

to

CHAY
FINE SAND
SAND GRAVEL

0 24
24 37
37 103

WELL LOCATION:

sec. 2 T 17 N R 2 W
2 miles WEST of M.C.
(distance) (direction) (nearest town)

WELL PURPOSE: DRINKING
(home, irrigation, municipal, industrial)

WELL COMPLETION DATA:

- (1) diameter (inches) 12"
- (2) total depth (feet) 103'
- (3) static water level (feet) 18' below top of ground.
- (4) casing BUK to 63' (material), (depth)
12" if telescope see back. (size)
- (5) screen 40' 63' (length), (depth to top)
12" BUK INVERT (size), (material)
- (6) pump 30 1700 (HP), (yield gpm)
ELEC. (type power)
- (7) electric log No (yes or no)
(organization running log)
- (8) how well bottom plugged RATE

CODED

REGISTERED


FEB 1 1974

DRILLERS REMARKS:

MISS. BD. OF WATER COMMISSIONERS

If well telescopes please sketch and show depths.

GROUND LEVEL

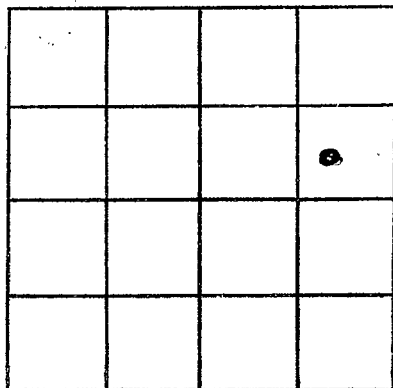

SECTION 2

Please indicate well location X.

ADDITIONAL INFORMATION

If more than one screen,
show locations of each on sketch.