

Leflore
 P 23
 10-16-69

MISSISSIPPI
 BOARD OF WATER COMMISSIONERS
 416 North State Street
 Jackson, Mississippi 39201

CODED

WATER WELL DRILLERS LOG

10-16 1969 BUTANE GAS Co. of G'wood Leflore
 date well completed firm name county well located

LANDOWNER:
 Douglas W. Holleman
 Swiftown Miss.
 (mailing address)

WELL LOCATION:
 sec. 24 T 17 N R 2 E
 3 1/2 miles S of Morgan City
 (distance) (direction) (nearest town)

WELL PURPOSE:
 (home, irrigation, municipal, industrial)

WELL COMPLETION DATA:

- (1) diameter (inches) 2"
- (2) total depth (feet) 1332
- (3) static water level (feet) 30 below above top of ground.
- (4) casing Steel 1302
 (material) (depth)
2" if telescope see back.
 (size)
- (5) screen 30' 1302
 (length) (depth to top)
2" Stainless Steel
 (size) (material)
- (6) pump _____ (HP) _____ (yield gpm)
 (type power)
- (7) electric log _____
 (yes or no)

 (organization running log)
- (8) how well bottom plugged
lead wool

description of formations encountered	from	to
Clay	0	23
SAND	23	72
SAND & PEA GRAVEL	72	120
SAND & CLAY STREAKS	120	599
HARD SHALE	599	717
ROCK	717	718
SANDY SHALE	718	976
BROWN SANDY SHALE	976	1018
SANDY SHALE	1018	1103
HARD SHALE	1103	1164
TIGHT SAND	1164	1251
HARD PACKED SAND	1251	1335
SHALE	1335	1346


OCT 20 1969

DRILLERS REMARKS:

MISSISSIPPI
 BOARD OF WATER COMMISSIONERS

If well telescopes please sketch and show depths.

GROUND LEVEL

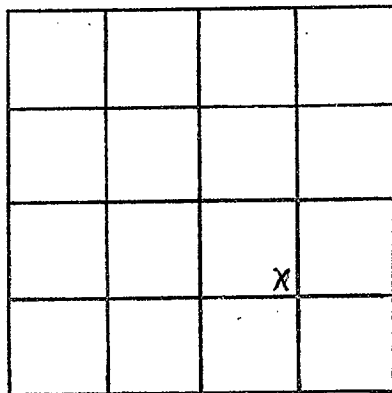

SECTION 24

Please indicate well location X.

ADDITIONAL INFORMATION

If more than one screen, show locations of each on sketch.