

Leflore
 P 24
 4-14-70

MISSISSIPPI
 BOARD OF WATER COMMISSIONERS
 416 North State Street
 Jackson, Mississippi 39201

CODED

WATER WELL DRILLERS LOG

4-14-70 19 DYER WELL & IRRIGATION SERVICE Leflore
 date well completed firm name county well located

LANDOWNER:
 R. P. Aust
 Swiftown, Miss.
 (mailing address)

description of formations encountered	from	to
Clay	0	43
COARSE SAND	43	73
SAND + GRAVEL	73	106

WELL LOCATION:
 sec. 34 T-17 N R-2 E
 3 miles E of Swiftown
 (distance) (direction) (nearest town)

WELL PURPOSE: Ed
 (home, irrigation, municipal, industrial)

- WELL COMPLETION DATA:
- (1) diameter (inches) 16"
 - (2) total depth (feet) 106
 - (3) static water level (feet) 2 below above top of ground.
 - (4) casing Steel 66
 (material) (depth)
16" If telescope see back.
 (size)
 - (5) screen 40' 66'
 (length) (depth to top)
16" Steel
 (size) (material)
 - (6) pump 60 3000
 (HP) (yield gpm)
LPGAS.
 (type power)
 - (7) electric log no
 (yes or no)

CODED

(organization running log)

APR 17 1970


(8) how well bottom plugged Plate

MISS. BD. OF.
 WATER COMM.

DRILLERS REMARKS:

If well telescopes please sketch and show depths.

GROUND LEVEL

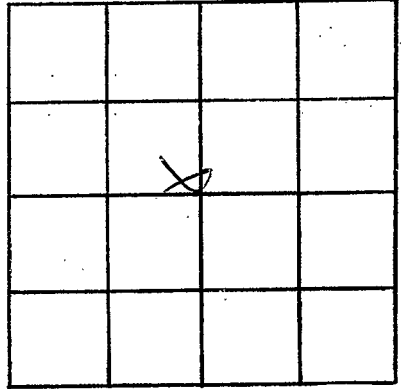

SECTION 34

Please indicate well location X.

ADDITIONAL INFORMATION

If more than one screen,
show locations of each on sketch.