

Leflore  
P 26  
7-10-70

MISSISSIPPI  
BOARD OF WATER COMMISSIONERS  
416 North State Street  
Jackson, Mississippi 39201

**CODED**

WATER WELL DRILLERS LOG

7/10/70 19 BUTANE GAS. CO. LEFLORE.  
date well completed firm name county well located

|  |                                       |      |    |
|--|---------------------------------------|------|----|
| LANDOWNER: <u>W. H. MORGAN</u><br><u>L. SON. MORGAN CITY.</u><br><u>MISS.</u><br>(mailing address) | description of formations encountered | from | to |
|  |                                       |      |    |
|  |                                       |      |    |

|   |  |  |  |
|---|--|--|--|
| WELL LOCATION:<br>sec. <u>6</u> T. <u>17</u> N. R. <u>2</u> E.<br><u>1 1/4</u> miles <u>S.E.</u> of <u>MORGAN CITY</u><br>(distance) (direction) (nearest town) |  |  |  |
|---|--|--|--|

WELL PURPOSE: IRRIGATION  
(home, irrigation, municipal, industrial)

- WELL COMPLETION DATA:
- (1) diameter (inches) 6"
  - (2) total depth (feet) 103
  - (3) static water level (feet) 17 below top of ground.
  - (4) casing 6' (material) 63 (depth)
  - (size) if telescope see back.
  - (5) screen 40 (length) 103 (depth to top)
  - (size) (material)
  - (6) pump 800 (HP) 800 (yield gpm)
  - (type power)
  - (7) electric log NO (yes or no)
  - (organization running log)
  - (8) how well bottom plugged STEEL PLATE

**CODED**

JUL 27 1970

DRILLERS REMARKS:  
MISS. BD. OF WATER COMM.


If well telescopes please sketch and show depths.

GROUND LEVEL

63'

(7 - Below)

40'

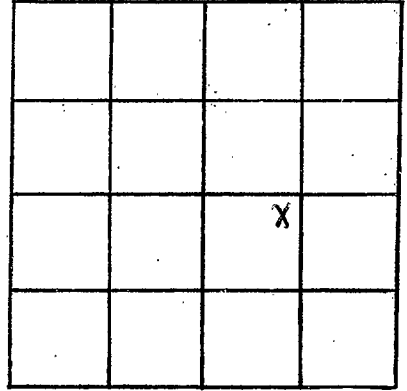

SECTION 6

Please indicate well location X.

ADDITIONAL INFORMATION

If more than one screen, show locations of each on sketch.