

LEFLORE

P27

11-6-73

MISSISSIPPI  
 BOARD OF WATER COMMISSIONERS  
 416 North State Street  
 Jackson, Mississippi 39201

WATER WELL DRILLERS LOG

11/6 date well completed

19 MOYER WELL & IRRIGATION SERVICE firm name

LEFLORE county well located

LANDOWNER: Henry Clement

description of formations encountered

from

to

GREENWOOD,

Clay  
Sand Gravel  
Rock

0 47  
47 97  
97 103

M 553

(mailing address)

WELL LOCATION:

sec. 11 T 17 N R 2 E  
 3 miles SW of MORNING  
 (distance) (direction) (nearest town)

WELL PURPOSE: IRR (home, irrigation, municipal, industrial)

WELL COMPLETION DATA:

- (1) diameter (inches) 16"
- (2) total depth (feet) 103'
- (3) static water level (feet) 8' below above top of ground.
- (4) casing BERTON 63' (material) (depth)  
16" if telescope see back. (size)
- (5) screen 40' 63' (length) (depth to top)  
16" BERTON (size) (material)
- (6) pump 60 3000 (HP) (yield gpm)  
ELEC. (type power)
- (7) electric log (yes or no)
- (organization running log)
- (8) how well bottom plugged PLATE


CODED

FEB 11 1974

DRILLERS REMARKS:

If well telescopes please sketch and show depths.

GROUND LEVEL

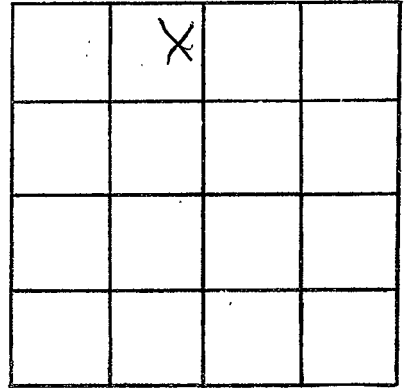

SECTION 11

Please indicate well location X.

ADDITIONAL INFORMATION

If more than one screen, show locations of each on sketch.