

LEFLORE

PZ8

11-9-73

MISSISSIPPI
 BOARD OF WATER COMMISSIONERS
 416 North State Street
 Jackson, Mississippi 39201

WATER WELL DRILLERS LOG CODED

11/9 1973 DYER WELL & IRRIGATION SERVICE LEFLORE
 date well completed firm name county well located

LANDOWNER: Henry Clements

description of formations encountered

from

to

GREEN WOOD,

Clay

0

27

MISS

Fine Sand

27

37

(mailing address)

Gravel

37

103

WELL LOCATION:

sec. 4 T. 17 N R. 2 E
 3 miles SW of Morgan City
 (distance) (direction) (nearest town)

WELL PURPOSE: DRINK
 (home, irrigation, municipal, industrial)


WELL COMPLETION DATA:

- (1) diameter (inches) 16"
- (2) total depth (feet) 103'
- (3) static water level (feet) 10' below top of ground.
- (4) casing PVC IR, 63'
 (material) (depth)
- 16"
 (size) if telescope see back.
- (5) screen 40', 63'
 (length) (depth to top)
- 16", BUC INEOS
 (size) (material)
- (6) pump 60 3000
 (HP) (yield gpm)
- Diesel
 (type power)
- (7) electric log No
 (yes or no)

CODED

(organization running log)

(8) how well bottom plugged Bar

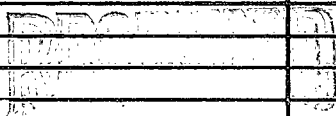


FEB 14 1974

DRILLERS REMARKS:

If well telescopes please sketch and show depths.

GROUND LEVEL

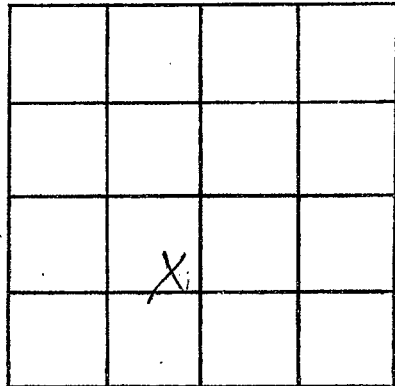

SECTION 4

Please indicate well location X.

ADDITIONAL INFORMATION

Lined area for additional information.

If more than one screen, show locations of each on sketch.