

LEFLORE

P 29

11-2-73

MISSISSIPPI
 BOARD OF WATER COMMISSIONERS
 416 North State Street
 Jackson, Mississippi 39201

CODED

WATER WELL DRILLERS LOG

DYER WELL & IRRIGATION SERVICE

LEFLORE

11/2 1973
date well completed

firm name

county well located

LANDOWNER: E.D. STRAIN

MORCAN City

77183

(mailing address)

description of formations encountered

from

to

CLAY

0 47

FINE SAND

47 55

SAND GRAVEL

55 103

WELL LOCATION:

sec. 23 T 17 N R 2 E
 4 1/2 miles SW of M.C.
 (distance) (direction) (nearest town)

WELL PURPOSE: DR.
 (home, irrigation, municipal, industrial)

WELL COMPLETION DATA:


- (1) diameter (inches) 16"
- (2) total depth (feet) 103'
- (3) static water level (feet) 8' below above top of ground.
- (4) casing BERTH, 63'
 (material) (depth)
16" if telescope see back.
 (size)
- (5) screen 40', 103'
 (length) (depth to top)
16", BERTH
 (size) (material)
- (6) pump 60 3000
 (HP) (yield gpm)
DIESOL
 (type power)
- (7) electric log No
 (yes or no)

(organization running log)

(8) how well bottom plugged BATE

DRILLERS REMARKS:

CODED

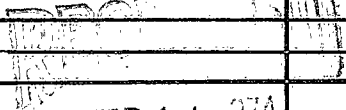

FEB 14 1974

MISS. Bd. OF WATER COMM.

If well telescopes please sketch and show depths.

GROUND LEVEL

X			

SECTION 23

Please indicate well location X.

ADDITIONAL INFORMATION

If more than one screen,
show locations of each on sketch.