

LEFLORE
P 30
11-4-73

MISSISSIPPI
 BOARD OF WATER COMMISSIONERS
 416 North State Street
 Jackson, Mississippi 39201

CODED

WATER WELL DRILLERS LOG

1114 1973 DYER WELL & IRRIGATION SERVICE LEFLORE
 date well completed firm name county well located

LANDOWNER: E.D. STRAIN
MORNING CITY,
MISSO.
 (mailing address)


description of formations encountered	from	to
CLAY	0	4.5
SAND GRAVELS	4.5	10.3

WELL LOCATION:
 sec. 13 T 11 N R 2 W
5 miles SW of M.C.
 (distance) (direction) (nearest town)

WELL PURPOSE: PRC
 (home, irrigation, municipal, industrial)

- WELL COMPLETION DATA:
- (1) diameter (inches) 16"
 - (2) total depth (feet) 103'
 - (3) static water level (feet) 8' below top of ground.
 - (4) casing PERK 63'
 (material) (depth)
16" if telescope see back.
 (size)
 - (5) screen 40' 63'
 (length) (depth to top)
16" PERK
 (size) (material)
 - (6) pump 60 3000
 (HP) (yield gpm)
EDEL
 (type power)
 - (7) electric log N/O
 (yes or no)
 - (organization running log)
 - (8) how well bottom plugged PLUG


CODED

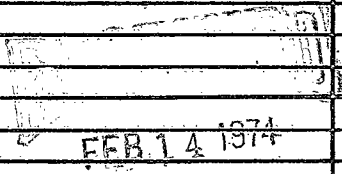

DRILLERS REMARKS:

If well telescopes please sketch and show depths.

GROUND LEVEL

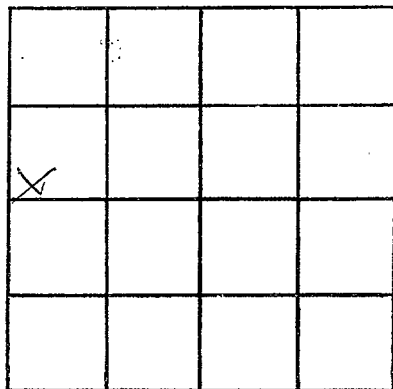

SECTION 23

Please indicate well location X.

ADDITIONAL INFORMATION

If more than one screen, show locations of each on sketch.