

LEFLORE

P 31

11-15-73

MISSISSIPPI
 BOARD OF WATER COMMISSIONERS
 416 North State Street
 Jackson, Mississippi 39201

CODED

WATER WELL DRILLERS LOG

11/15
date well completed

1973 DYER WELL & IRRIGATION SERVICE
firm name

LEFLORE
county well located

LANDOWNER: E. D. STRAIN

description of formations encountered

from

to

MORGAN CITY

Clay
Sand Gravel

0 47
47 103

Miss.

(mailing address)

WELL LOCATION:

sec. 13 T 17 N R 2 E
 4 1/2 miles SW of M.C.
 (distance) (direction) (nearest town)

WELL PURPOSE: PEC.
(home, irrigation, municipal, industrial)


CODED

WELL COMPLETION DATA:

- (1) diameter (inches) 16"
- (2) total depth (feet) 103'
- (3) static water level (feet) 7 below above top of ground.
- (4) casing PVC, 63'
(material) (depth)
16" If telescope see back.
(size)
- (5) screen 40', 63'
(length) (depth to top)
16", PVC
(size) (material)
- (6) pump 60 3000
(HP) (yield gpm)
ELSC
(type power)
- (7) electric log N/D
(yes or no)

(organization running log)

(8) how well bottom plugged None

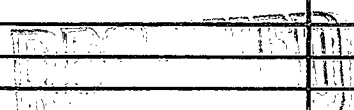

FEB 1 1974

DRILLERS REMARKS:

MISS. Bd. OF WATER COMMISSIONERS

If well telescopes please sketch and show depths.

GROUND LEVEL

X			

SECTION 13

Please indicate well location X.

ADDITIONAL INFORMATION

If more than one screen,
show locations of each on sketch.