

LEFLORE

P 32

11-19-73

MISSISSIPPI  
 BOARD OF WATER COMMISSIONERS  
 416 North State Street  
 Jackson, Mississippi 39201

CODED

WATER WELL DRILLERS LOG

no County  
LEFLORE

11/19  
date well completed

1973 DYER WELL & IRRIGATION SERVICE

firm name

county well located

LANDOWNER: Robert Morton

description of formations encountered

from

to

MORGAN CITY

Clay  
FINE SAND  
GRAVEL

0 27  
27 40  
40 103

17183

(mailing address)

WELL LOCATION:

sec. 24 17 N R. 2 E  
6 miles S.W. of M.C.  
(distance) (direction) (nearest town)

WELL PURPOSE: D.R.  
(home, irrigation, municipal, industrial)


WELL COMPLETION DATA:

- (1) diameter (inches) 16"
- (2) total depth (feet) 103'
- (3) static water level (feet) 8' below top of ground.
- (4) casing BUR IR 63' (material) (depth)  
16" (size) if telescope see back.
- (5) screen 40' 63' (length) (depth to top)  
16" BUR IR 60' (size) (material)
- (6) pump 3/4 HP 3000 (HP) (yield gpm)  
DIESEL (type power)
- (7) electric log NO (yes or no)

CODED

(organization running log)

(8) how well bottom plugged Packed

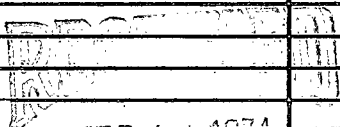


FEB 14 1974

DRILLERS REMARKS:

MISS. BD. OF WATER COMMISSIONERS

If well telescopes please sketch and show depths.

GROUND LEVEL

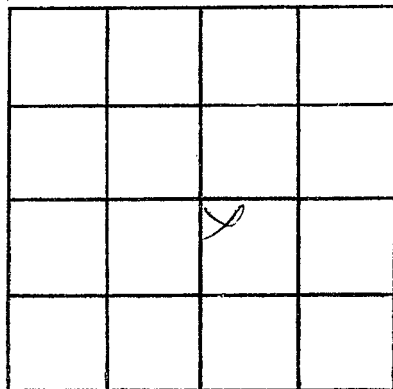

SECTION 24

Please indicate well location X.

ADDITIONAL INFORMATION

If more than one screen, show locations of each on sketch.