

LEFLORE
P 34
5-17-74

MISSISSIPPI
 BOARD OF WATER COMMISSIONERS
 416 North State Street
 Jackson, Mississippi 39201

CODED

WATER WELL DRILLERS LOG

MAY 17, 74
 date well completed

RYER WELL & IRRIGATION SERVICE
 firm name

LEFLORE
 county well located

LANDOWNER:

A. MAUR KIMBROUGH
SIDON, MISS
 (mailing address)

description of formations encountered

	from	to
CLAY	0	17
COARSE SAND & RED ROCK	17	36
COARSE SAND, PEA	36	
ROCK, & GRAVEL		109

WELL LOCATION:


sec. **9** T. **16** N R. **2** E
4 miles **So.** of **Phlox City**
 (distance) (direction) (nearest town)

WELL PURPOSE: IRR.
 (home, irrigation, municipal, industrial)

WELL COMPLETION DATA:

- (1) diameter (inches) **16"**
- (2) total depth (feet) **109'**
- (3) static water level (feet) **14'** below top of ground.
- (4) casing **BURTR**, **69'**
 (material) (depth)
16" if telescope see back.
 (size)
- (5) screen **40'** **69'**
 (length) (depth to top)
16" **BURTR**
 (size) (material)
- (6) pump **60** **3000**
 (HP) (yield gpm)
DIESEL
 (type power)
- (7) electric log **No**
 (yes or no)
- (organization running log)
- (8) how well bottom plugged **PLATE**

CODED

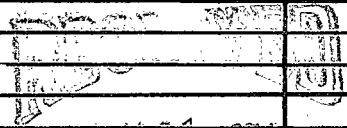


NOV 21 1974

DRILLERS REMARKS:

If well telescopes please
sketch and show depths.

GROUND LEVEL

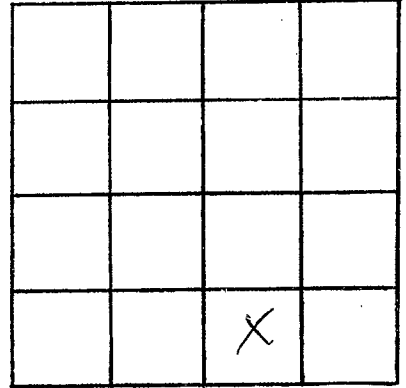

SECTION 9

Please indicate well location X.

ADDITIONAL INFORMATION

If more than one screen,
show locations of each on sketch.