

LEFLORE

P 35

6-20-74

MISSISSIPPI BOARD OF WATER COMMISSIONERS 416 North State Street Jackson, Mississippi 39201

CODED

WATER WELL DRILLERS LOG

DYER WELL & IRRIGATION SERVICE

LEFLORE

June 20, 1974 date well completed

firm name

county well located

LANDOWNER:

FRED POWDERTEA

description of formations encountered

from

to

MORGAN City, Miss. (mailing address)

CLAY 1 22 SAND COARSE 22 38 COARSE SAND PER ROCK 38 53 COARSE SAND, PER ROCK, GRAVEL 53 103

WELL LOCATION:

sec. 4 T. 17 N. R. 1 E. 4 miles S.E. of MORGAN CITY (distance) (direction) (nearest town)

WELL PURPOSE: IRR. (home, irrigation, municipal, industrial)


WELL COMPLETION DATA:

- (1) diameter (inches) 12 (2) total depth (feet) 103 (3) static water level (feet) 18' below top of ground. (4) casing BLUE IR. 63' (material) (depth) 12" (size) if telescope see back. (5) screen 40 63' (length) (depth to top) 12" BLUE IN BOT (size) (material) (6) pump 40 1800 (HP) (yield gpm) GLEC (type power) (7) electric log No (yes or no)

CODED

(organization running log)

(8) how well bottom plugged PLATE

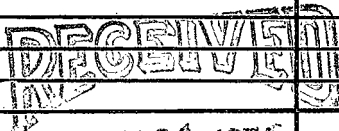


NOV 21 1974

DRILLERS REMARKS:

MISS. BD. OF WATER COMMISSIONERS

If well telescopes please sketch and show depths.

GROUND LEVEL

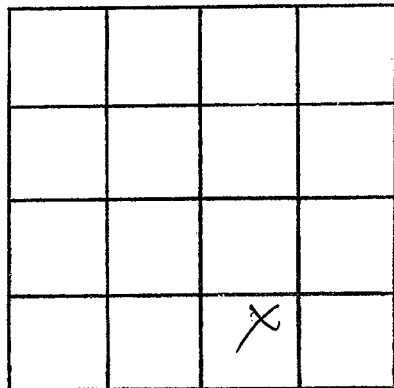

SECTION 4

Please indicate well location X.

ADDITIONAL INFORMATION

If more than one screen,
show locations of each on sketch.