

LEFLORE
P38
2-7-75

MISSISSIPPI
BOARD OF WATER COMMISSIONERS
416 North State Street
Jackson, Mississippi 39201

CODED

WATER WELL DRILLERS LOG

2-7-75 19 EUTANE GAS CO. OF GREENWOOD Le flore
date well completed firm name county well located

LANDOWNER:
W. H. MORGAN
MORGAN City
(mailing address)

description of formations encountered	from	to
CLAY	0	46
SAND	46	50
SAND & GRAVEL	50	75
GRAVEL	75	94
White Clay	94	97


WELL LOCATION:
sec. 7 T. 17 N. R. 1 E. W. W
2 miles S of M. City
(distance) (direction) (nearest town)

WELL PURPOSE: IRR.
(home, irrigation, municipal, industrial)

- WELL COMPLETION DATA:
- (1) diameter (inches) 6"
 - (2) total depth (feet) 97
 - (3) static water level (feet) 16 below above top of ground.
 - (4) casing Steel, 54,
(material) (depth)
6" if telescope see back.
(size)
 - (5) screen 40', 54
(length) (depth to top)
6", Steel
(size) (material)
 - (6) pump 30 1000
(HP) (yield gpm)
Diesel
(type power)
 - (7) electric log No
(yes or no)
- (organization running log)
- (8) how well bottom plugged Steel Plate

CODED


DRILLERS REMARKS:

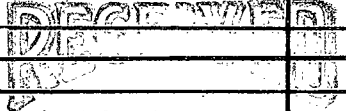

FEB 12 1975

If well telescopes please sketch and show depths.

GROUND LEVEL

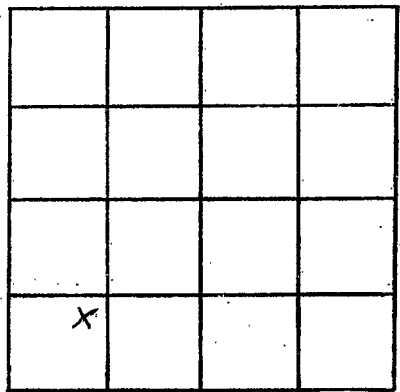

SECTION 7

Please indicate well location X.

ADDITIONAL INFORMATION

A series of horizontal lines for recording additional information.

If more than one screen, show locations of each on sketch.