

Wetlore  
P40

WATER WELL DRILLERS LOG CODED

9-17-64

Date: SEPT. 17, 1964, Driller: DELTA DRILLING Co. County LEFLORE  
(Name)


		Description & Color of Materials Sand, Clay, Red Clay, Shell, etc.	Thick- ness Feet	Depth Feet
(1) Owner of Land:	<u>ALLEN M. KIMBROUGH</u> (Name)	<u>GUMBO</u>	<u>43</u>	<u>43</u>
	<u>MORGAN CITY, MISS</u> (Address)	<u>SAND</u>	<u>21</u>	<u>64</u>
(2) Location:	<u>NE 1/4, SE 1/4, Sec. 9 T10R1W</u>	<u>GRAVEL</u>	<u>72</u>	<u>136</u>
	<u>_____ miles _____ of _____</u> (distance) (direction) (Nearest Town)	<u>GUMBO CODED</u>	<u>74</u>	<u>210</u>
(3) Topography:	<u>_____</u> (Hilly) (Flat) (Level)	<u>SAND</u>	<u>101</u>	<u>311</u>
(4) Purpose of Well:	<u>DOMESTIC</u> (Domestic Irrigation Municipal, Industrial, Other)	<u>GUMBO</u>	<u>142</u>	<u>453</u>
		<u>SAND</u>	<u>83</u>	<u>536</u>
		<u>GUMBO W/ROCKS.</u>	<u>44</u>	<u>580</u>
		<u>SHALE</u>	<u>133</u>	<u>713</u>
		<u>GREEN SAND W/ROCKS</u>	<u>126</u>	<u>839</u>
		<u>SHALE</u>	<u>54</u>	<u>893</u>
		<u>SAND</u>	<u>54</u>	<u>947</u>
		<u>SHALE</u>	<u>12</u>	<u>959</u>
		<u>BROWN SAND</u>	<u>29</u>	<u>988</u>
		<u>SHALE W/ROCKS</u>	<u>42</u>	<u>1030</u>
		<u>GREEN SAND</u>	<u>20</u>	<u>1050</u>
		<u>SHALE</u>	<u>28</u>	<u>1078</u>
		<u>GUMBO</u>	<u>37</u>	<u>1115</u>
		<u>SHALE</u>	<u>43</u>	<u>1158</u>
		<u>FINE SAND</u>	<u>31</u>	<u>1189</u>
		<u>WHITE SAND</u>	<u>33</u>	<u>1222</u>
		<u>GUMBO</u>	<u>18</u>	<u>1240</u>
		<u>SAND</u>	<u>51</u>	<u>1291</u>
		<u>GUMBO</u>	<u>2</u>	<u>1293</u>

Information upon completion of well:

- (1) Diameter 3 inches.
- (2) Total Depth 1293 feet. *yield 70 gpm*
- (3) Water Level FLOWS feet below top of ground. 3" 680'
- (4) Cased to 1273, Size 2" 629
- (5) Screen: Size 2" 1/2, Length 20'
- (6) Were any formations sealed against pollution?  
\_\_\_\_\_ yes, \_\_\_\_\_ no.

If YES depth of formation \_\_\_\_\_  
Why \_\_\_\_\_

Drillers Remarks: WELL FLOWS  
APPROXIMATELY 70 G.P.M.  
16' LAP OF 2" IN 3" PIPE

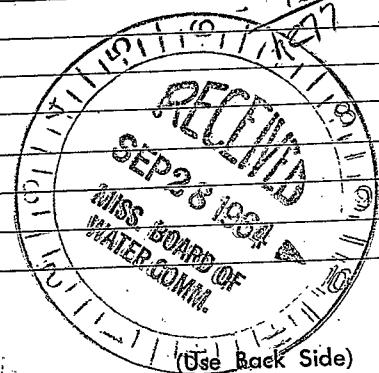

*1293*  
*16*  
*1277*  
*680'*  
*679*  
*1309*  
*9*

Well No.

Mail this copy to BOBIC