

CFlore
PAI
5-66

MISSISSIPPI BOARD OF WATER COMMISSIONERS

WATER WELL DRILLERS LOGGED

Date: May 4, 1966, Driller: Butane Gas Co. County Leflore
(Name)

(1) Owner of Land: E. D. Strain, Jr.
(Name)
Morgan City, Miss.
(Address)

(2) Location: NW 1/4, NW 1/4, Sec. 6 T. 17 N. R. 1 W.
South of Morgan
1 1/2 miles West of City
(distance) (direction) (Nearest Town)

(3) Topography: Flat
(Hilly) (Flat) (Level)

(4) Purpose of Well: Irrigation
(Domestic Irrigation
Municipal, Industrial, Other)

Description & Color of Materials Sand, Clay, Red Clay, Shell, etc.	Thick- ness Feet	Depth Feet
<u>Top Soil</u>	<u>13</u>	<u>13</u>
<u>Clay</u>	<u>10</u>	<u>23</u>
<u>Clay</u>	<u>10</u>	<u>33</u>
<u>Coarse Sand</u>	<u>10</u>	<u>43</u>
" "	<u>10</u>	<u>53</u>
" " & gravel	<u>10</u>	<u>63</u>
" " & gravel	<u>10</u>	<u>73</u>
" " & gravel	<u>10</u>	<u>83</u>
CODED & gravel	<u>10</u>	<u>93</u>
" " & gravel	<u>10</u>	<u>103</u>

Information upon completion of well:

(1) Diameter 16 inches.

(2) Total Depth 103 feet.

(3) Water Level 14 feet below top of ground.


(4) Cased to 63, Size 16.

(5) Screen: Size 16, Length 40.

(6) Were any formations sealed against pollution?
 yes, no.

If YES depth of formation _____
 Why _____

Drillers Remarks: _____

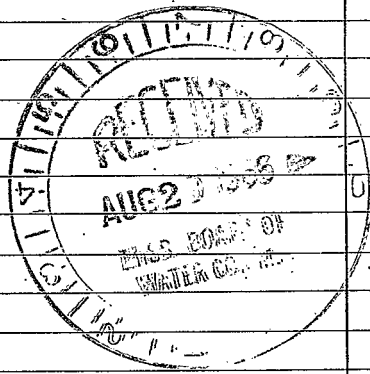

(Use Back Side)

Well No.

